

# City of Prince George

## HISTORY SHEET

PID: 029334080

Scale: 1:1000

Legal: LOT 13

D.L.: 4045

PLAN: EPP32590

Address: 4655 AVTAR PL

Sanitary Connection:# SIZE: 100mmØ MATERIAL: PVC INV. 609.34m CONNECTED

Water Connection:# SIZE: 19mmØ MATERIAL: copper INV. 608.54m METER

Storm Connection:# SIZE: 100mmØ MATERIAL: PVC INV. 609.38m CONNECTED

Cash Receipt No's: WATER SANITARY STORM

CURB FROM PROPERTY LINE 5m PAVEMENT WIDTH 10m

B.C. HYDRO 75mm DB2

B.C. TELEPHONE 100mm DB2


TERASEN 42 PROP/P.E.

Information Sheets: REFERENCE DRAWINGS L&M ENGINEERING LIMITED JOB NO. 1256-04-04

Comments: CS CURB STOP SDW WATER SERVICE HT HYDRO SERVICE GAS  
CO CLEAN OUT STORM SERVICE CABLE SERVICE ELECTRICAL  
SANITARY SERVICE TELECOMMUNICATIONS

THE INFORMATION CONTAINED HEREIN IS FOR INTERNAL USE ONLY.

NOT TO BE RELIED UPON UNLESS CONFIRMED BY THE SITE INSPECTION AND/OR INVESTIGATION

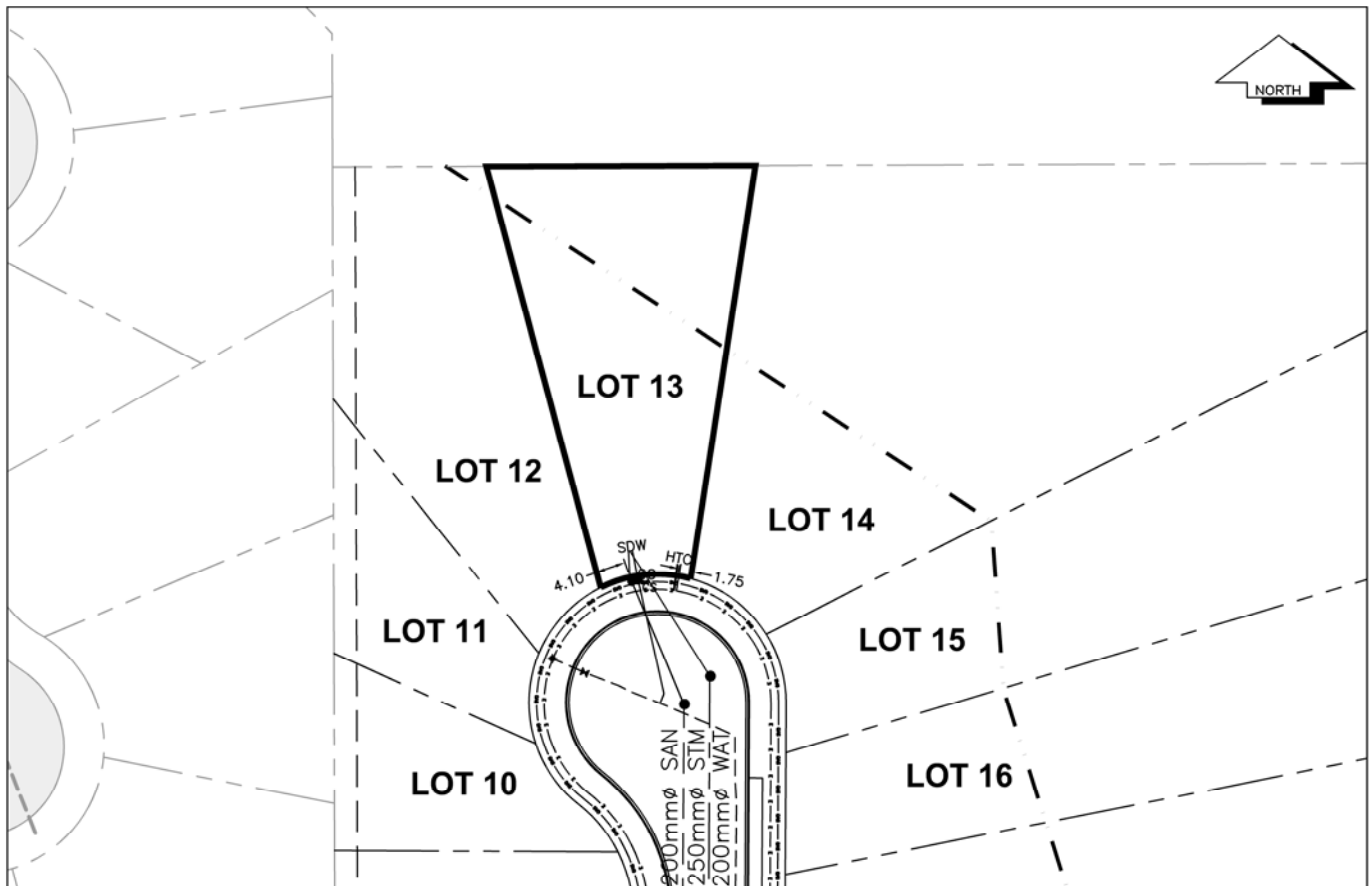

SANITARY, STORM & WATER SERVICE INVERTS	SANITARY	WATER	STORM
1. Distance from San. M.H. <u>5247</u> toward San. M.H. <u>5247</u> to lot service connection point is:	0m	N/A	N/A
1a.Distance from Stm. M.H. <u>3810</u> toward Stm. M.H. <u>3810</u> to lot service connection point is:	N/A	N/A	0m
2. Main Size at connection point is	200mm	200mm	250mm
3. Invert of main at conn. stub point is	608.75m	608.02m	609.11m
4. Invert at service end is	609.43m	608.63m	609.43m
5. Cut at property line in meters	3.36m	4.19m	3.24m
6. Survey Date: OCT 2012 Book Ref.:1256-04-04 By:ALLNORTH			

SANITARY HISTORY:

Installed By: Klein and Sons Construction

---

---

WATER HISTORY:

Installed By: Klein and Sons Construction

---

---

STORM HISTORY:

Installed By: Klein and Sons Construction

---

---

