
## City of Prince George HISTORY SHEET

PID: 02933415	Scale: 1:1000								
Legal: LOT 20						D.L.:	4045	PLAN:	EPP32590
Address: 4614 AVTAR	PL								
Sanitary Connection:#		SIZE:	100mmØ	MATERIAL:	PVC	IN	v. 605.55m	CONNEC	CTED
Water Connection:#		SIZE:	19mmØ	MATERIAL:	copper	IN	v. 604.85m	METER	
Storm Connection:#		SIZE	100mmØ	MATERIAL	PVC	IN	v. 605.53m	CONNEC	TED
Cash Receipt No's:	Cash Receipt No's:		WATER	TER SANITA		RY		STORM	
CURB FROM PROPERTY LINE 5m				F			PAVEMENT WIDTH 10m		
B.C. HYDRO	75mm DB2								
B.C. TELEPHONE	100mm DB2								
TERASEN	42 PROP/P.E	Ē							
Information Sheets:	REFERENCE	E DRAWIN	GS L&M ENGIN	NEERING LIMITE					
Comments:	CS CUF	RB STOP AN OUT	<u> </u>	WATER SERVICE STORM SERVICE SANITARY SERV	ICE	======================================	YDRO SERVICE ABLE SERVICE ELECOMMUNICAS	- <b></b> -	GAS ELECTRICAL

THE INFORMATION CONTAINED HEREIN IS FOR INTERNAL USE ONLY. NOT TO BE RELIED UPON UNLESS CONFIRMED BY THE SITE INSPECTION AND/OR INVESTIGATION

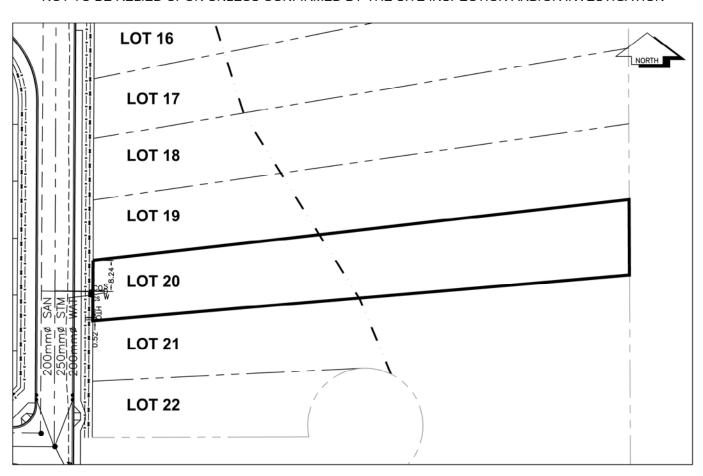

SANITARY, STORM & WATER SERVICE INVERTS	SANITARY	WATER	STORM
1. Distance from San. M.H. <u>5246</u> toward San. M.H. <u>5247</u> to lot service connection point is:	37m	N/A	N/A
1a.Distance from Stm. M.H. 3809 toward Stm. M.H. 3810 to lot service connection point is:	N/A	N/A	41m
2. Main Size at connection point is	200mm	200mm	250mm
3. Invert of main at conn. stub point is	605.19m	604.56m	605.10m
4. Invert at service end is	605.63m	604.97m	605.65m
5. Cut at property line in meters	2.28m	3.02m	2.32m
6. Survey Date: OCT 2012 Book Ref.:1256-04-04 By:ALLNORTH			
SANITARY HISTORY:			
Installed By: Klein and Sons Construction			
WATER HISTORY:			
Installed By: Klein and Sons Construction			
STORM HISTORY:			
Installed By: Klein and Sons Construction			