

# City of Prince George

## HISTORY SHEET

PID: 029334217

Scale: 1:500

Legal: LOT 1

D.L.: 4050

PLAN: EPP32590

Address: 4478 STURGEON ROAD

Sanitary Connection:# SIZE: 100mmØ MATERIAL: PVC INV. 603.14m CONNECTED

Water Connection:# SIZE: 19mmØ MATERIAL: copper INV. 603.38m METER

Storm Connection:# SIZE: 100mmØ MATERIAL: PVC INV. 603.18m CONNECTED

Cash Receipt No's: WATER SANITARY STORM

CURB FROM PROPERTY LINE 4.59m PAVEMENT WIDTH 10m

B.C. HYDRO 75mm DB2

B.C. TELEPHONE 100mm DB2


TERASEN 42 PROP/P.E.

Information Sheets: REFERENCE DRAWINGS L&M ENGINEERING LIMITED JOB NO. 1256-04-04

Comments: CS CURB STOP SDW WATER SERVICE HYDRO SERVICE GAS  
CO CLEAN OUT STORM SERVICE CABLE SERVICE  
SANITARY SERVICE TELECOMMUNICATIONS ELECTRICAL

THE INFORMATION CONTAINED HEREIN IS FOR INTERNAL USE ONLY.

NOT TO BE RELIED UPON UNLESS CONFIRMED BY THE SITE INSPECTION AND/OR INVESTIGATION

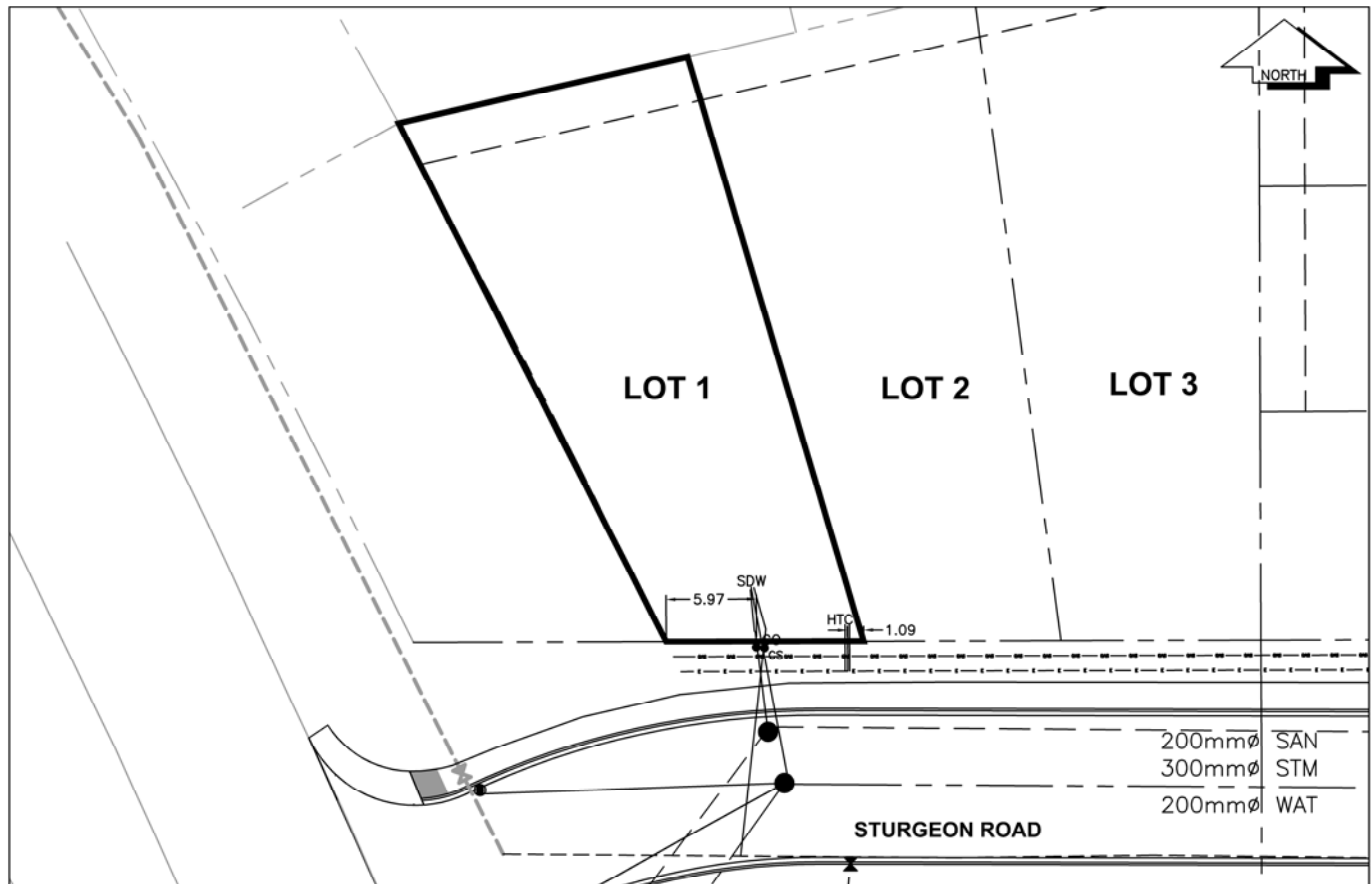

SANITARY, STORM & WATER SERVICE INVERTS	SANITARY	WATER	STORM
1. Distance from San. M.H. <u>5245</u> toward San. M.H. <u>5246</u> to lot service connection point is:	0m	N/A	N/A
1a.Distance from Stm. M.H. <u>3808</u> toward Stm. M.H. <u>3809</u> to lot service connection point is:	N/A	N/A	0m
2. Main Size at connection point is	200mm	200mm	300mm
3. Invert of main at conn. stub point is	602.74m	603.26m	602.80m
4. Invert at service end is	603.30m	603.41m	603.30m
5. Cut at property line in meters	3.01m	2.85m	2.97m
6. Survey Date: OCT 2012 Book Ref.:1256-04-04 By:ALLNORTH			

### SANITARY HISTORY:

Installed By: Klein and Sons Construction

### WATER HISTORY:

Installed By: Klein and Sons Construction

### STORM HISTORY:

Installed By: Klein and Sons Construction