



City of Prince George History Sheet

PID:	029353025
MU:	101442
WO:	73296

Civic Address: 880 Great St

Legal Description: Lot: A District Lot: 485 Plan: EPP41889


Service Type	Diameter (mm)	Material	Invert Elev at main (m)	Depth of Cut at property line (m)	Invert Elev at service end (m)	Distance into property (m)	Installation Date
Sanitary	100mm	PVC	589.47	1.51	589.55	-	September 2006
Water	150mm	AC	-	-	-	-	September 2006
Storm	375mm	PVC	-	-	-	-	September 2006
Storm	100mm	PVC	-	-	-	-	September 2013

Service Connection Location				Sanitary (m)	Storm (m)
Distance from downstream San MH	4980	towards upstream San MH	4100	79.00	
375mm Storm service connected to Stm MH 3476					

Power	Size	Communications	Size	Cable	Size	Gas	Size
BC Hydro	-	Telus	-	Shaw	-	FortisBC	-
Overhead Service		Overhead Service		Overhead Service			

Installed by:	Survey Date:	-
Comments:		

NOT TO SCALE The information contained herein is for internal use only.
Not to be relied on unless confirmed by site inspection and/or investigation.

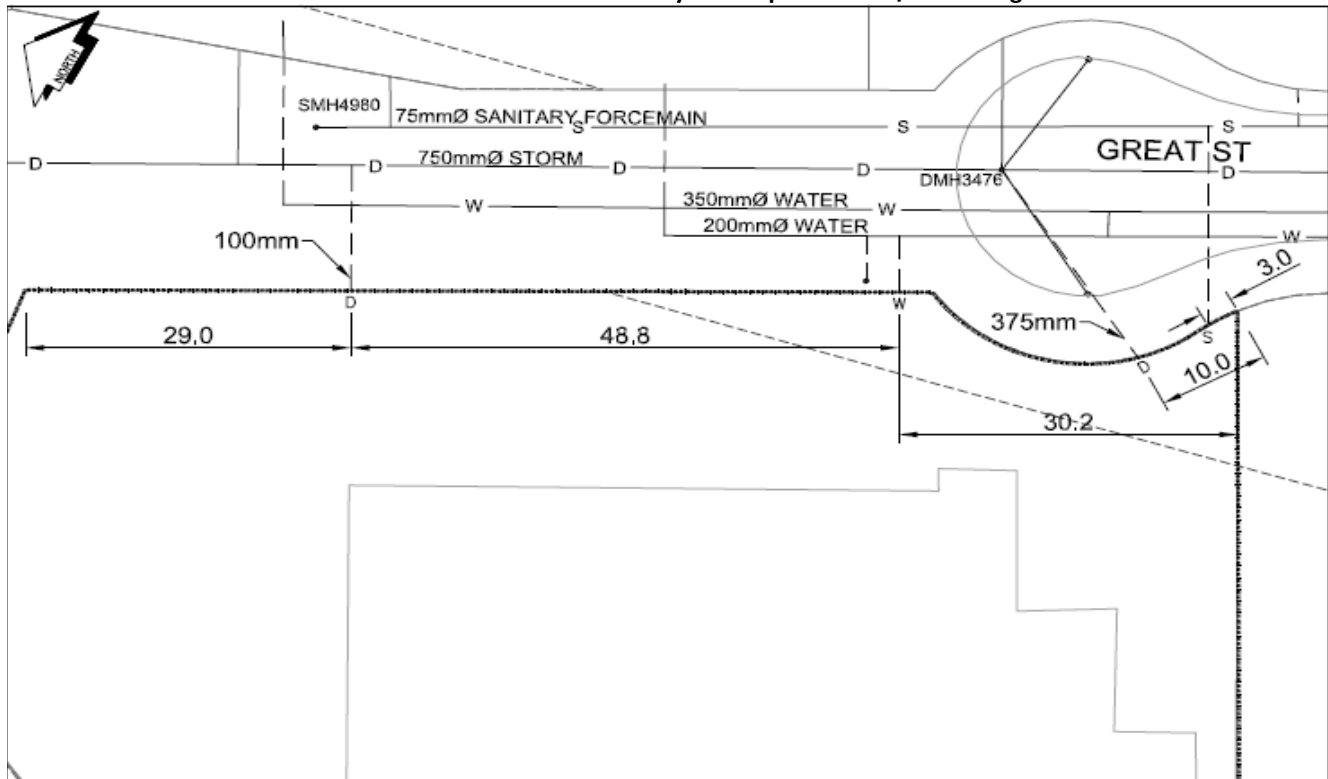

CS ^o CURB STOP	--- W WATER SERVICE	--- S STORM SERVICE
CO ^o CLEAN OUT	--- S SANITARY SERVICE	--- G GAS

NOT TO SCALE