



# City of Prince George History Sheet

PID:	029356954
SD/MU:	
WO:	

Civic Address: 1689 9th Avenue  
1692 10th Avenue

Legal Description: Lot: A Block: 195 District Lot: 343 Plan: EPP42717


Service Type	Diameter (mm)	Material	Invert Elev at main (m)	Invert Elev at property line (m)	Invert Elev at service end (m)	Distance into property (m)	Installation Date
Sanitary (9th Ave)	100mm	AC	-	-	-	-	January 1957
Sanitary(10th Ave)	150mm	AC	-	-	-	-	January 1957
Water(9th Ave)	20mm	Copper	-	-	-	-	January 1957
Water(10th Ave)	100mm	PVC	-	-	-	-	January 1957
Storm(10th Ave)	150mm	PVC	-	-	-	-	January 1957

Service Connection Location				Sanitary (m)	Storm (m)
Distance from downstream San MH	2857	towards upstream San MH	3094	97.6	
150mm Sanitary service connected to San MH on 10th Ave+				-	
150mm Storm service connected to Stm Mh on 10th Ave					

Power	Size	Communications	Size	Cable	Size	Gas	Size
BC Hydro	-	Telus	-	Shaw	-	FortisBC	-
Overhead Service		Overhead Service		Overhead Service			

Installed by:		Survey Date:	-
Comments:	Service locations confirmed October 2016.		
Manhole in laneway has leads as shown - no service to 1692 10th Ave			

**NOT TO SCALE** The information contained herein is for internal use only.  
Not to be relied on unless confirmed by site inspection and/or investigation.

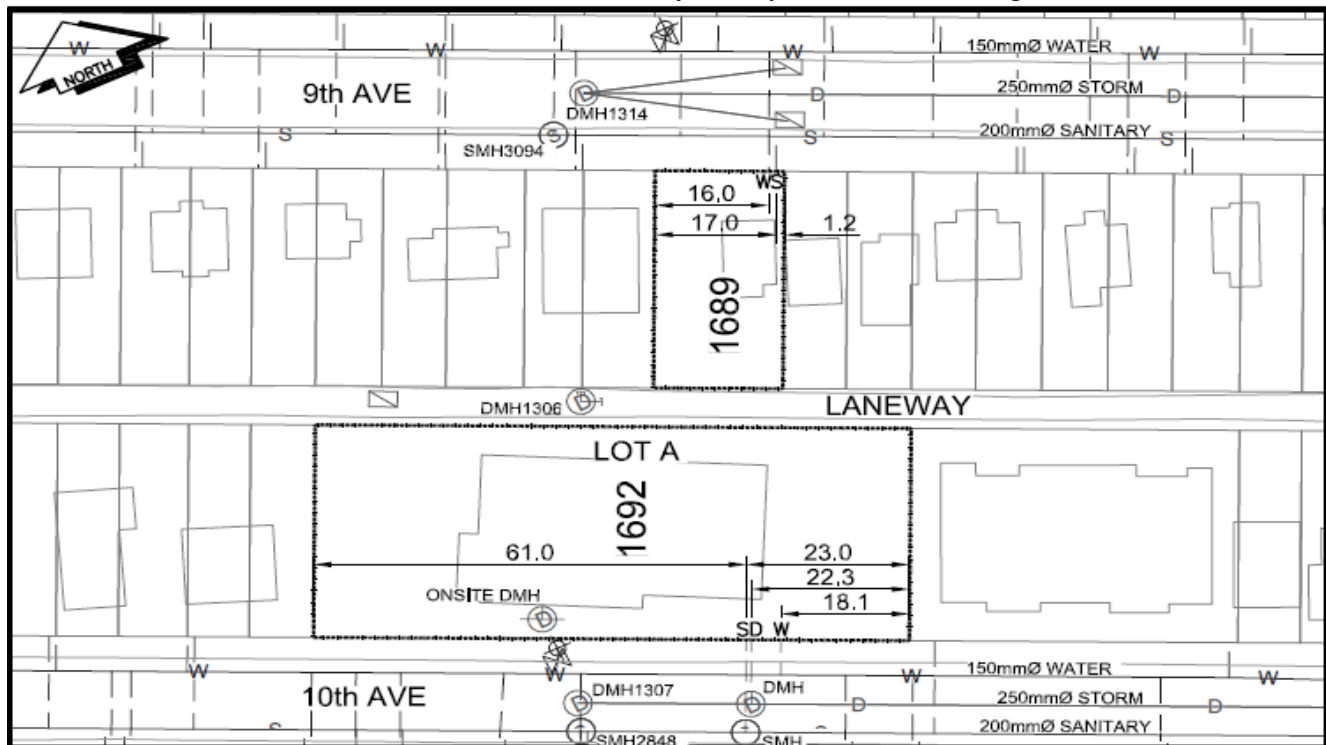

LEGEND:	CS CURE STOP	--- WATER SERVICE	--- STORM SERVICE
	CO CLEAN OUT	--- SANITARY SERVICE	--- GAS

**NOT TO SCALE**