

City of Prince George  
HISTORY SHEET

PID 029372445

~~005977061~~

SHEET NUMBER

Roll Number

Legal: LOT'S ~~A~~ PCL A BLOCK D.L. 932 PLAN 28584

Address: 1375 STRATHCONA

Sanitary Connection: # 16016. SIZE 100mm. MATERIAL PVC INV. 567.188 CONNECTED

Water Connection # 16016. SIZE 20mm. MATERIAL Copper METER CONNECTED

Storm Connection: # SIZE MATERIAL INV. CONNECTED

Cash Receipt No's: WATER 571 SANITARY 572 STORM

CURB FROM PROPERTY LINE PAVEMENT WIDTH


B.C. HYDRO UNDERGROUND CONNECTION

B.C. TELEPHONE UNDERGROUND CONNECTION

INLAND GAS

Information Sheets:

Comments:

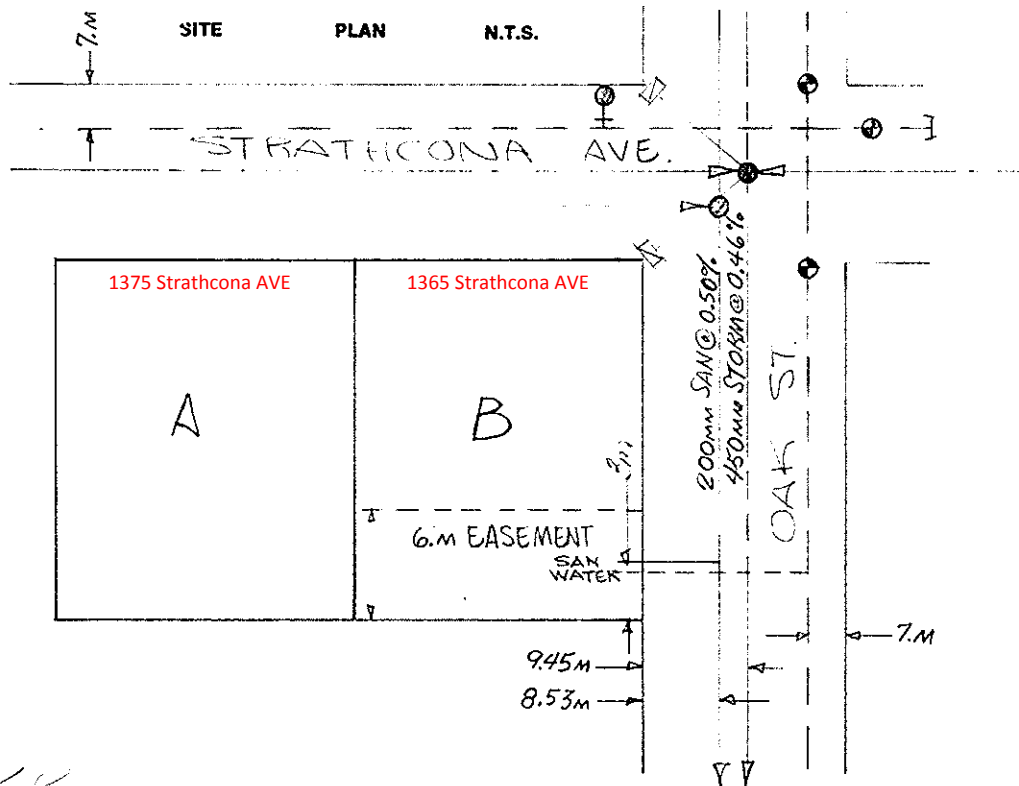

City of Prince George  
HISTORY SHEET

PID 029372445

~~004338090~~

SHEET NUMBER

Roll Number

Legal: LOT'S ~~B~~ PCL A BLOCK D.L. 932 PLAN 28384

Address: 1365 STRATHCONA

Sanitary Connection: # 6943 SIZE 100mm MATERIAL AC INV. CONNECTED

Water Connection # 6943 SIZE 20mm MATERIAL Cu METER CONNECTED

Storm Connection: # SIZE MATERIAL INV. CONNECTED

Cash Receipt No's: WATER 35 SANITARY 34 STORM

CURB FROM PROPERTY LINE PAVEMENT WIDTH

B.C. HYDRO UNDERGROUND CONNECTION

B.C. TELEPHONE UNDERGROUND CONNECTION

INLAND GAS

Information Sheets:

Comments:

