



City of Prince George History Sheet

PID:	029379695
SD:	100440
WO:	

Civic Address: 901 Central Street West

Legal Description: Lot: A District Lot: 936 Plan: EPP36984


Service Type	Diameter (mm)	Material	Invert Elev at main (m)	Invert Elev at property line (m)	Invert Depth at property (m)	Distance into property (m)	Installation Date
Sanitary	200mm	Unknown	1.00	597.03	2.09	3.00	June 1969
Water	50mm	Copper	-	-	-	-	
Water	100mm	Copper	-	-	-	-	
Storm	300mm	Unknown	-	597.91	1.19	-	June 1969

Service Connection Location	Sanitary (m)	Storm (m)
200mm Sanitary service connected to San MH 1958	-	
300mm Storm service connected to Stm MH 2116		

Power	Size	Communications	Size	Cable	Size	Gas	Size
BC Hydro	-	Telus	-	Shaw	-	FortisBC	-
Overhead Service		Overhead Service		Overhead Service			

Installed by:	City of Prince George forces	Survey Date:	-
Comments:	Water services are in the same trench		

NOT TO SCALE The information contained herein is for internal use only.
Not to be relied on unless confirmed by site inspection and/or investigation.

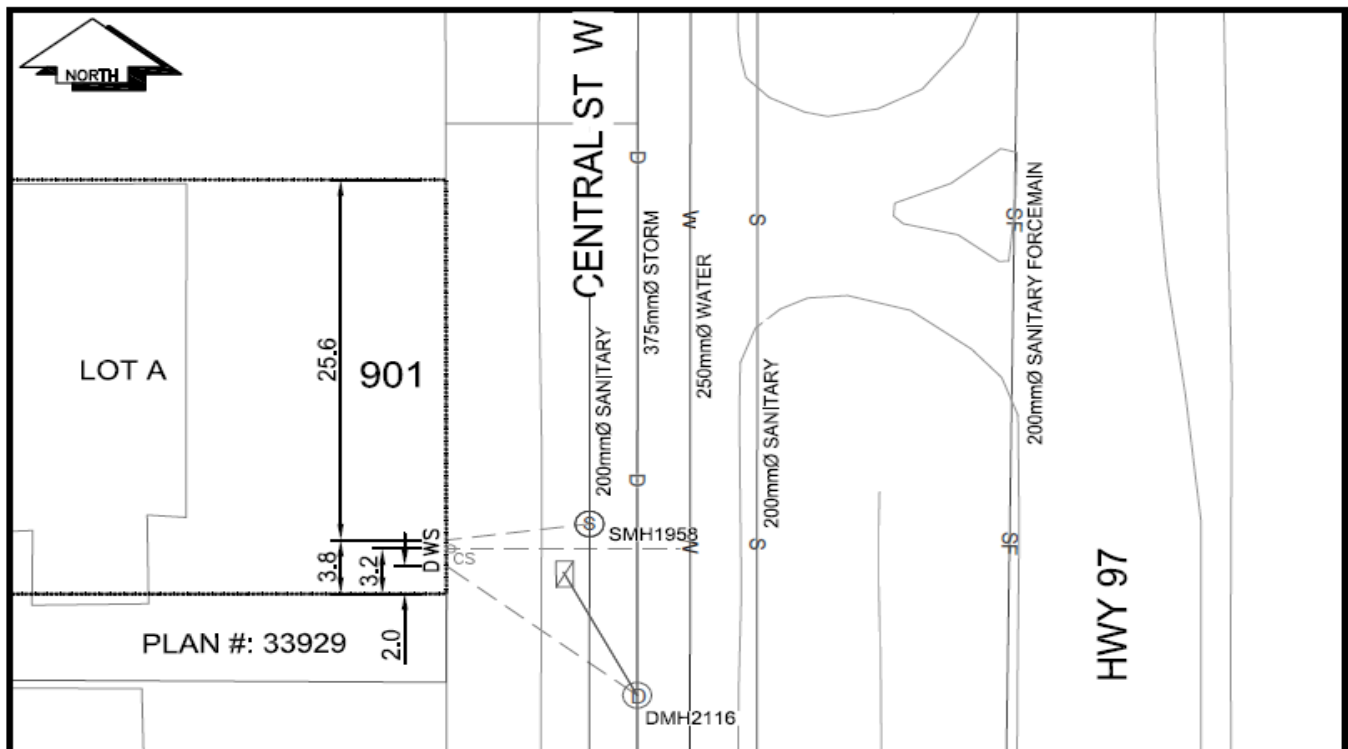

CS ^o CURB STOP	--- W WATER SERVICE	--- D STORM SERVICE
CO ^o CLEAN OUT	--- S SANITARY SERVICE	--- G GAS

NOT TO SCALE