



# City of Prince George History Sheet

PID:	029379709
SD	100440
WO:	

Civic Address: 3240 3244 10th Avenue

Legal Description: Lot: B District Lot: 936 Plan: EPP36984


Service Type	Diameter (mm)	Material	Invert Elev at main (m)	Invert Elev at property line (m)	Invert Elev at service end (m)	Distance into property (m)	Installation Date
Sanitary	100mm	AC	-	-	-	-	-
Water	25mm	Copper	-	-	-	-	January 1965
Storm	200mm	Vit	-	-	-	-	

Service Connection Location					Sanitary (m)	Storm (m)
Distance from downstream San MH	2748	towards upstream San MH	2747		25.29	
Distance from downstream Stm MH	2118	towards upstream Stm MH	2117			36.20

Power	Size	Communications	Size	Cable	Size	Gas	Size
BC Hydro	-	Telus	-	Shaw	-	FortisBC	-
Overhead Service		Overhead Service		Overhead Service			

Installed by:	Survey Date:	-
Comments: Water service location confirmed October 2016.		

**NOT TO SCALE** The information contained herein is for internal use only.  
Not to be relied on unless confirmed by site inspection and/or investigation.

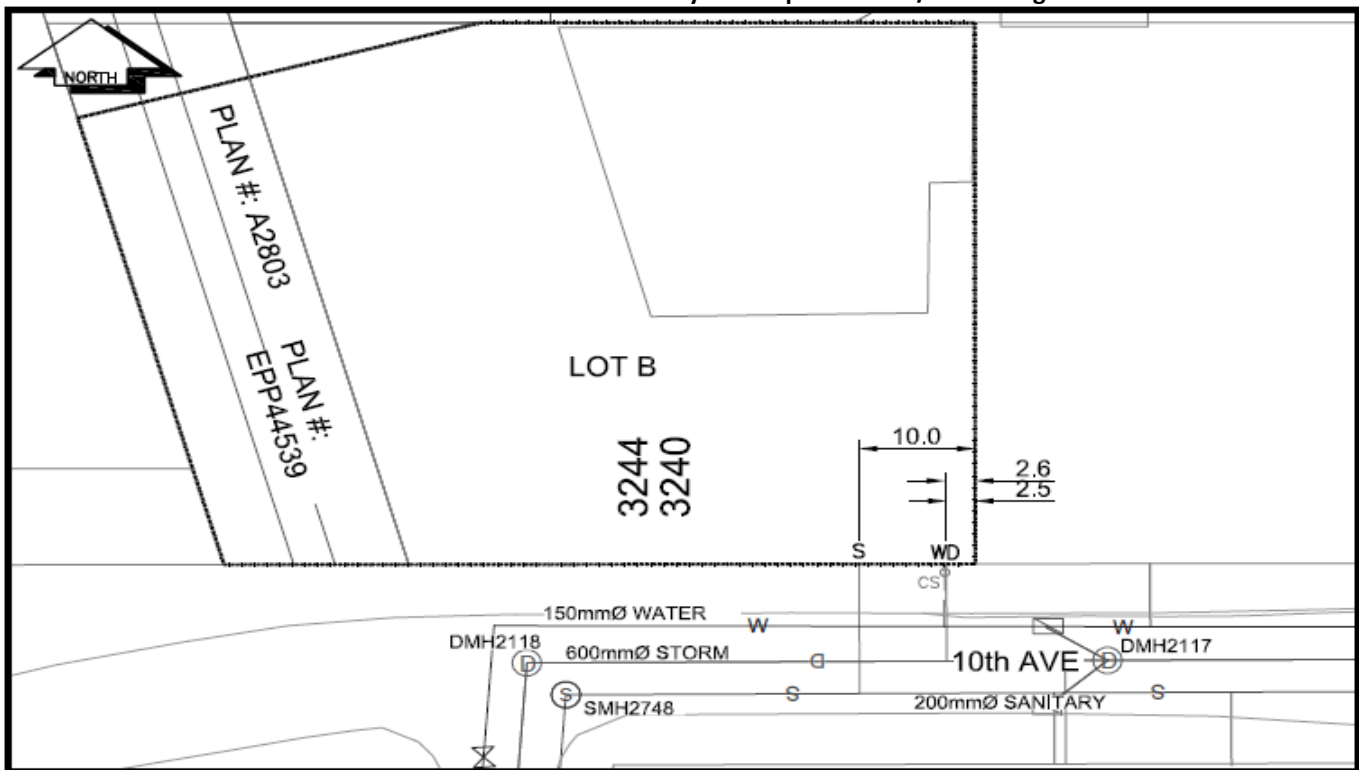

LEGEND:	CS CURB STOP	--- WATER SERVICE	--- STORM SERVICE
	CO CLEAN OUT	--- SANITARY SERVICE	--- GAS

**NOT TO SCALE**