



City of Prince George History Sheet

PID:	029418178
SD/MU:	MU101570
WO:	81812

Civic Address: 2883 Andres Rd

Legal Description: Lot: B District Lot: 1433 Plan: EPP41583


Service Type	Diameter (mm)	Material	Invert Elev at main (m)	Invert Elev at property line (m)	Invert Elev at service end (m)	Distance into property (m)	Installation Date
Sanitary	100mm	PVC	-	-	-	3.00	Ocr 2014
Water	20mm	Copper	-	-	-	3.00	Ocr 2014
Storm	100mm	PVC	-	-	-	3.00	Ocr 2014

Service Connection Location				Sanitary (m)	Storm (m)
Distance from downstream San MH	4088	towards upstream San MH	4089	68.80	
Distance from downstream Stm MH	1610	towards upstream Stm MH	1611		71.60

Power	Size	Communications	Size	Cable	Size	Gas	Size
BC Hydro	-	Telus	-	Shaw	-	FortisBC	-
Underground Service		Underground Service		Underground Service			

Installed by:	City of Prince George forces	Survey Date:	
Comments:			

NOT TO SCALE The information contained herein is for internal use only.
Not to be relied on unless confirmed by site inspection and/or investigation.

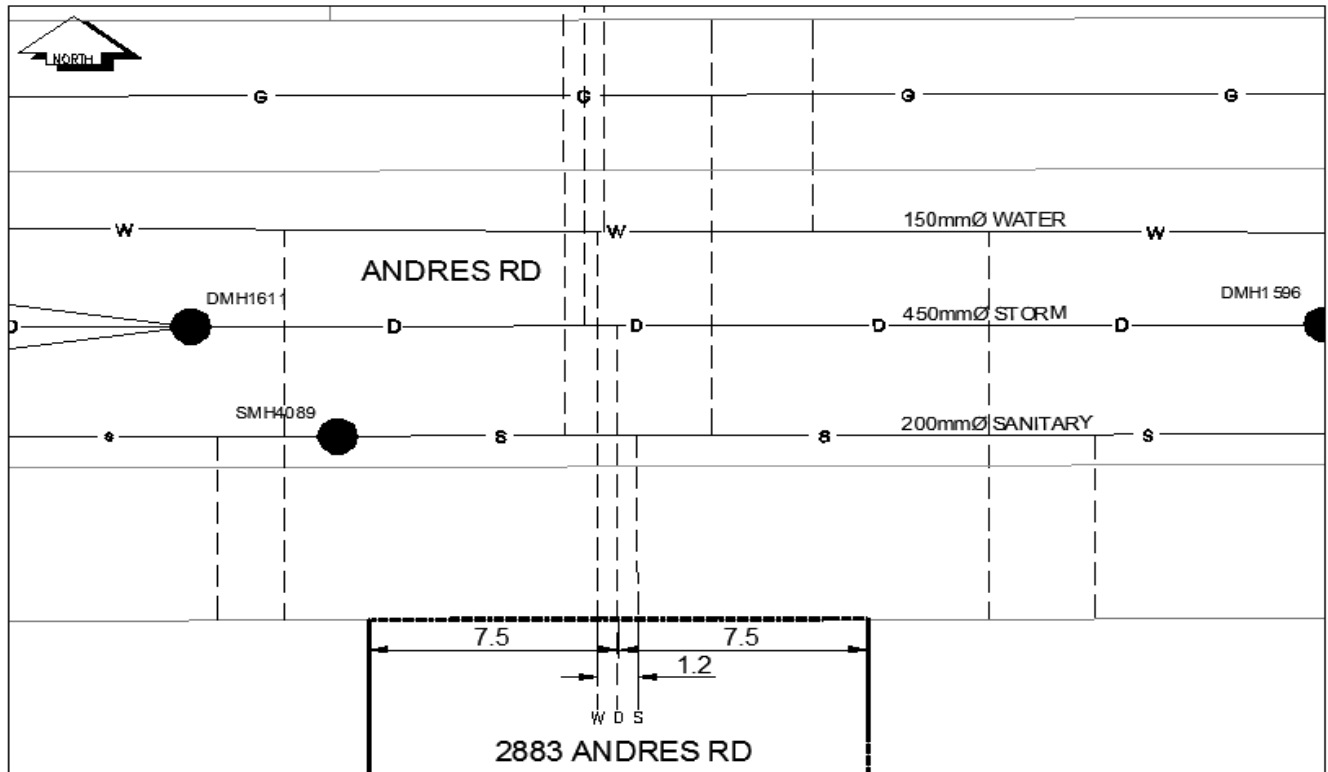

LEGE ND:	CS CURB STOP	--- WATER SERVICE	--- STORM SERVICE
	CO CLEAN OUT	--- SANITARY SERVICE	--- GAS

NOT TO SCALE