



City of Prince George History Sheet

PID:	029423872
MU:	101480
WO:	

Civic Address: 6356 Lalonde Rd

Legal Description: Lot: A District Lot: 2003 Plan: EPP45222


Service Type	Diameter (mm)	Material	Invert Elev at main (m)	Invert Elev at property line (m)	Invert Depth at service end (m)	Distance into property (m)	Installation Date
Sanitary	100mm	PVC	-	680.67	3.82	-	January 1983
Water	20mm	Copper	-	-	-	-	January 1978
Storm	N/A	N/A	-	-	-	-	

Service Connection Location				Sanitary (m)	Storm (m)
Distance from downstream San MH	4164	towards upstream San MH	4167	118.75	
Distance from downstream Stm MH		towards upstream Stm MH	-		

Power	Size	Communications	Size	Cable	Size	Gas	Size
BC Hydro	-	Telus	-	Shaw	-	FortisBC	-
Overhead Service		Overhead Service		Overhead Service			

Installed by:	Survey Date:	-
Comments:		

NOT TO SCALE The information contained herein is for internal use only.
Not to be relied on unless confirmed by site inspection and/or investigation.

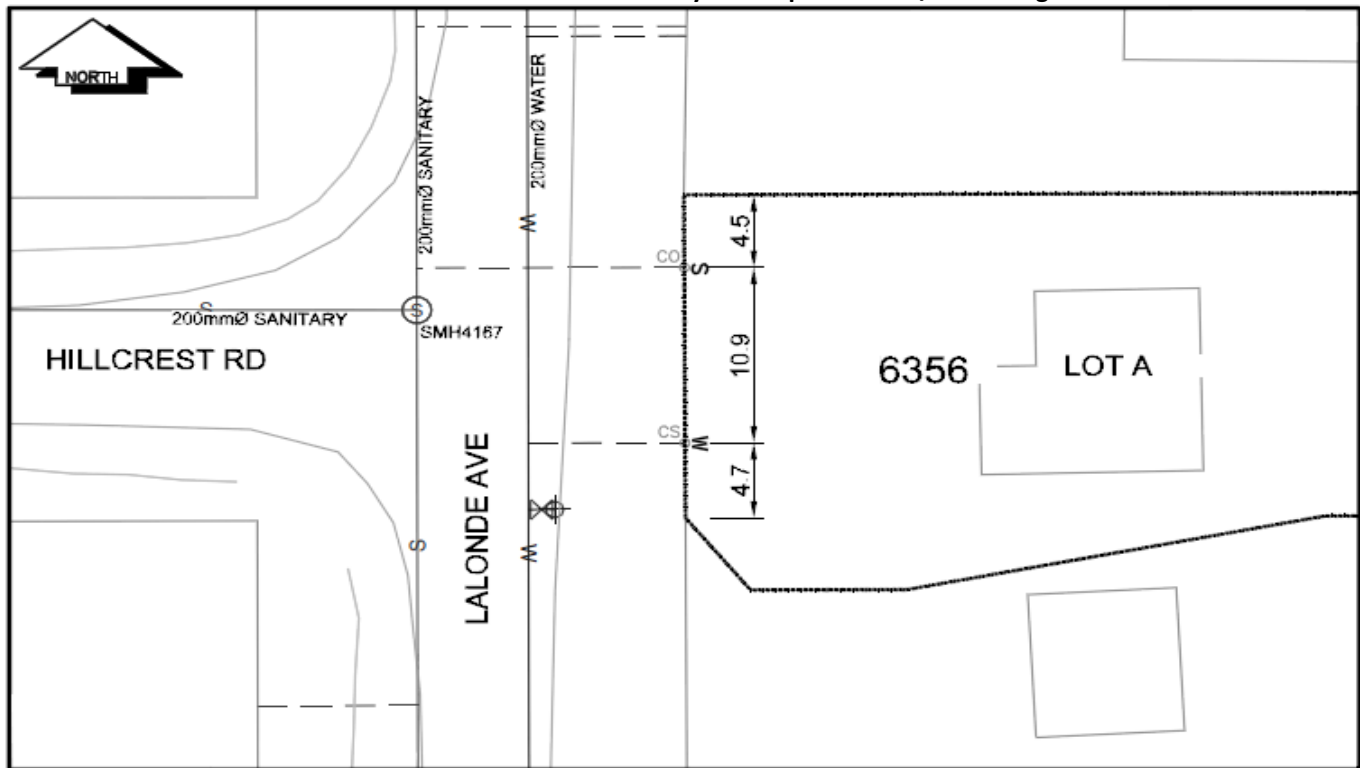

CS CURB STOP	--- M --- WATER SERVICE	--- S --- STORM SERVICE
CO CLEAN OUT	--- S --- SANITARY SERVICE	--- G --- GAS
WV WATER VALVE	--- F --- FIRE HYDRANT	--- E --- ENCUMBRANCE

NOT TO SCALE