



City of Prince George History Sheet

PID:	029423872
MU:	101480
WO:	79150/79151

Civic Address: 6372 Lalonde Rd

Legal Description: Lot: B District Lot: 2003 Plan: EPP45222


Service Type	Diameter (mm)	Material	Invert Elev at main (m)	Invert Elev at property line (m)	Invert Elev at service end (m)	Distance into property (m)	Installation Date
Sanitary	100mm	PVC	-	684.65	684.65	0.32	May 2016
Water	20mm	Copper	683.27	683.87	683.87	-	May 2016
Storm	N/A	N/A	-	-	-	-	

Service Connection Location				Sanitary (m)	Storm (m)
Distance from downstream San MH	4167	towards upstream San MH	4238	20.68	
Distance from downstream Stm MH	-	towards upstream Stm MH	-		

Power	Size	Communications	Size	Cable	Size	Gas	Size
BC Hydro	-	Telus	-	Shaw	-	FortisBC	-
Overhead Service		Overhead Service		Overhead Service			

Installed by:	City of Prince George forces	Survey Date:	-
Comments:			

NOT TO SCALE The information contained herein is for internal use only.
Not to be relied on unless confirmed by site inspection and/or investigation.

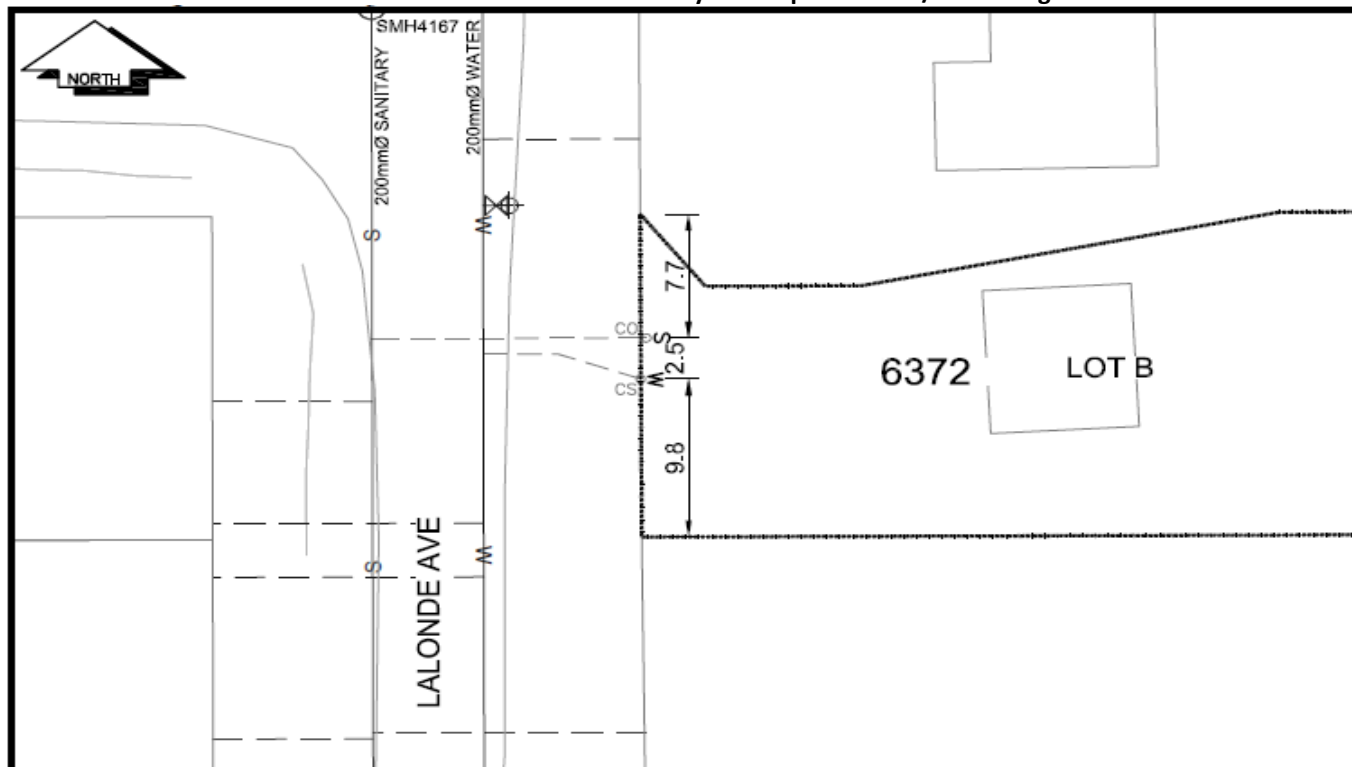

CS ^o CURB STOP	--- W --- WATER SERVICE	--- S --- SANITARY SERVICE	--- G --- GAS
CO ^o CLEAN OUT	--- M --- FIRE HYDRANT	--- D --- STORM SERVICE	--- ENCUMBERANCE
⊗ WATER VALVE			

NOT TO SCALE