



City of Prince George
History Sheet

PID:	029427436
MU:	101493
WO:	79664

Civic Address: 7205 Dagg Rd

Legal Description: Lot: 2 District Lot: 4047 Plan: EPP42686


Service Type	Diameter (mm)	Material	Invert Elev at main (m)	Invert Elev at property line (m)	Invert Elev at service end (m)	Distance into property (m)	Installation Date
Sanitary	100mm	PVC	-	-	-	3.00	September 2014
Water	20mm	Copper	-	-	-	3.00	September 2014
Storm	N/A	N/A	-	-	-	-	

Service Connection Location						Sanitary (m)	Storm (m)
Distance from downstream San MH	265	towards upstream San MH	226			58.40	
Distance from downstream Stm MH	-	towards upstream Stm MH	-				

Power	Size	Communications	Size	Cable	Size	Gas	Size
BC Hydro	-	Telus	-	Shaw	-	FortisBC	-
Overhead Service		Overhead Service		Overhead Service			

Installed by:	City of Prince George forces	Survey Date:	-
Comments:			

NOT TO SCALE The information contained herein is for internal use only.
Not to be relied on unless confirmed by site inspection and/or investigation.

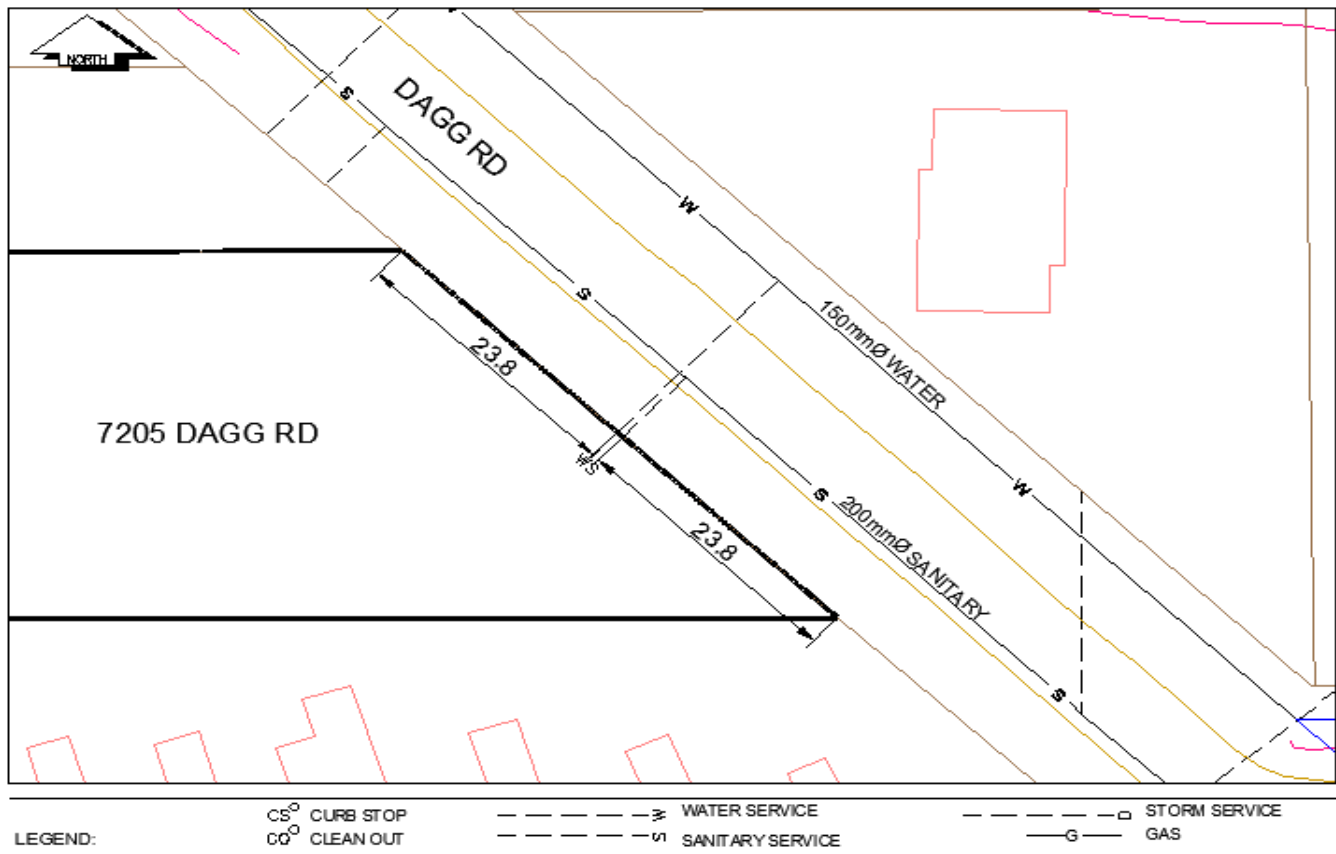

NOT TO SCALE