



City of Prince George History Sheet

PID:	029429099
MU:	101136
WO:	63961

Civic Address: 4157 Barnes Dr

Legal Description: Lot: A District Lot: 9261 Plan: EPP11216


Service Type	Diameter (mm)	Material	Invert Elev at main (m)	Invert Elev at property line (m)	Invert Elev at service end (m)	Distance into property (m)	Installation Date
Sanitary	100mm	PVC	-	-	-	-	August 2012
Water	20mm	Copper	-	-	-	-	August 2012
Storm	100mm	PVC	-	-	-	-	August 2012

Service Connection Location	Sanitary (m)	Storm (m)
100mm Sanitary service connected to San MH3647	-	
Storm service connected to Stm MH 1837		

Power	Size	Communications	Size	Cable	Size	Gas	Size
BC Hydro	-	Telus	-	Shaw	-	FortisBC	-
Underground Service		Underground Service		Underground Service			

Installed by:	City of Prince George Forces	Survey Date:	-
Comments:	Service locations confirmed August 29, 2012 by UTOPS		

NOT TO SCALE The information contained herein is for internal use only.
Not to be relied on unless confirmed by site inspection and/or investigation.

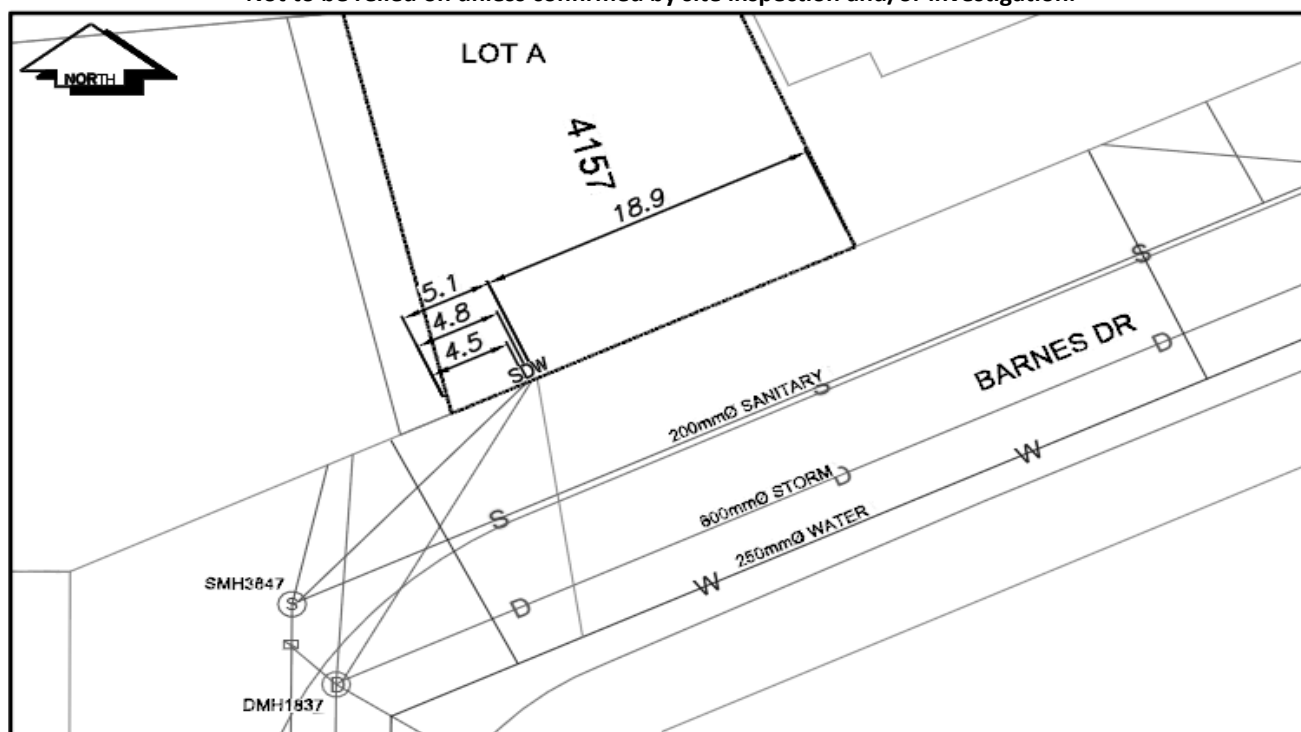

CS CURB STOP	WATER SERVICE	STORM SERVICE
CO CLEAN OUT	SANITARY SERVICE	GAS
WATER VALVE	FIRE HYDRANT	ENCUMBRANCE

NOT TO SCALE