



City of Prince George History Sheet

PID:	029431531
MU:	101502
WO:	79516/79517

Civic Address: 8677 Sparwood Rd

Legal Description: Lot: B District Lot: 2424 Plan: EPP42056


Service Type	Diameter (mm)	Material	Invert Elev at main (m)	Invert Elev at property line (m)	Invert Depth at service end (m)	Distance into property (m)	Installation Date
Sanitary	100mm	PVC	-	-	-	-	September 2014
Water	20mm	Copper	-	-	-	-	September 2014
Storm	N/A	N/A	-	-	-	-	

Service Connection Location						Sanitary (m)	Storm (m)
Distance from downstream San MH	81	towards upstream San MH	64			111.25	
Distance from downstream Stm MH	-	towards upstream Stm MH	-				

Power	Size	Communications	Size	Cable	Size	Gas	Size
BC Hydro	-	Telus	-	Shaw	-	FortisBC	-
Overhead Service		Overhead Service		Overhead Service			

Installed by:	City of Prince George forces	Survey Date:	-
Comments:			

NOT TO SCALE The information contained herein is for internal use only.
Not to be relied on unless confirmed by site inspection and/or investigation.

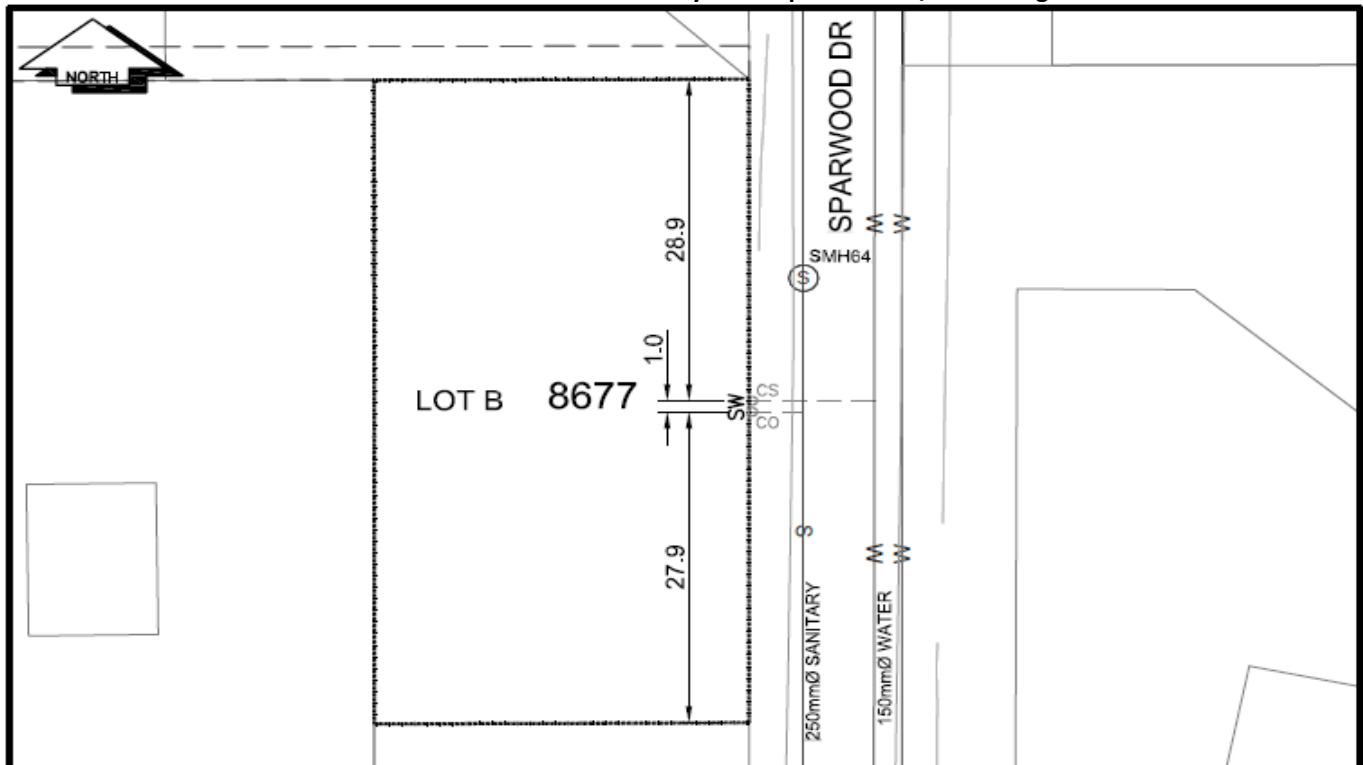

CS CURB STOP	--- M --- WATER SERVICE	--- S --- SANITARY SERVICE	--- G --- GAS	--- S --- STORM SERVICE
CO CLEAN OUT	--- S --- SANITARY SERVICE	--- G --- GAS	--- S --- STORM SERVICE	--- S --- STORM SERVICE
WATER VALVE	--- S --- SANITARY SERVICE	--- G --- GAS	--- S --- STORM SERVICE	--- S --- STORM SERVICE
	--- S --- SANITARY SERVICE	--- G --- GAS	--- S --- STORM SERVICE	--- S --- STORM SERVICE

NOT TO SCALE