



City of Prince George History Sheet

PID:	029439922
MU:	101512
WO:	82473/82475

Civic Address: 468 Wainwright St
470 Wainwright St

Legal Description: Lot: PCL B Block: 62 District Lot: 343 Plan: 1268


Service Type	Diameter (mm)	Material	Invert Elev at main (m)	Invert Elev at property line (m)	Invert Depth at service end (m)	Distance into property (m)	Installation Date
Sanitary (468)	100mm	PVC	-	-	-	-	March 2015
Sanitary (470)	100mm	PVC	-	586.86	2.04	-	January 1957
Water (468)	20mm	Copper	-	-	-	-	March 2015
Water (470)	20mm	Copper	-	-	-	-	January 1957
Storm	N/A	N/A	-	-	-	-	

Service Connection Location				Sanitary (m)	Storm (m)
Distance from downstream San MH	1653	towards upstream San MH	987	65.27	
Distance from downstream San MH	1653	towards upstream San MH	987	77.06	

Power	Size	Communications	Size	Cable	Size	Gas	Size
BC Hydro	-	Telus	-	Shaw	-	FortisBC	-
Overhead Service		Overhead Service		Overhead Service			

Installed by:	City of Prince George forces	Survey Date:	-
Comments:			

NOT TO SCALE The information contained herein is for internal use only.
Not to be relied on unless confirmed by site inspection and/or investigation.

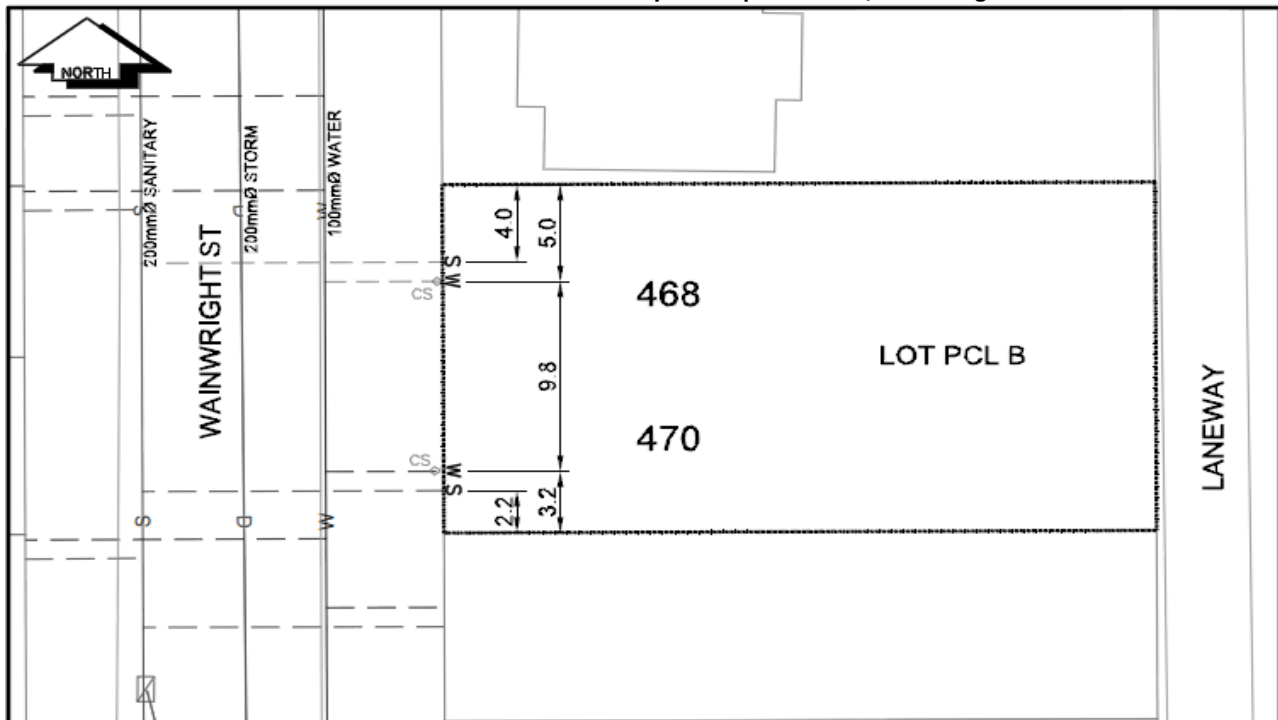

CS	CURB STOP	---	WATER SERVICE	---	STORM SERVICE
CO	CLEAN OUT	---	SANITARY SERVICE	---	GAS
⊗	WATER VALVE	⊗	FIRE HYDRANT	---	ENCUMBRANCE

NOT TO SCALE