



City of Prince George History Sheet

PID:	029458803
SD/MU:	
WO:	

Civic Address: 3915 Barnes Dr

Legal Description: Lot: 26 District Lot: 1433 Plan: EPP42273


Service Type	Diameter (mm)	Material	Invert Elev at main (m)	Invert Elev at property line (m)	Invert Depth at service end (m)	Distance into property (m)	Installation Date
Sanitary	100mm	PVC	648.56	649.05	2.94	3.00	July 2014
Water	20mm	Copper	648.34	649.05	3.06	3.00	July 2014
Storm	100mm	PVC	648.67	649.04	2.97	3.00	July 2014

Service Connection Location					Sanitary (m)	Storm (m)
Distance from downstream San MH	5262	towards upstream San MH	5241		54.80	
Distance from downstream Stm MH	3804	towards upstream Stm MH	3542			11.22

Power	Size	Communications	Size	Cable	Size	Gas	Size
BC Hydro	-	Telus	-	Shaw	-	FortisBC	-
Underground Service		Underground Service		Underground Service			

Installed by:	Joe Roberts Construction Service	Survey Date:	-
Comments:	Water and sanitary locate confirmed in April 2019		

NOT TO SCALE The information contained herein is for internal use only.
Not to be relied on unless confirmed by site inspection and/or investigation.

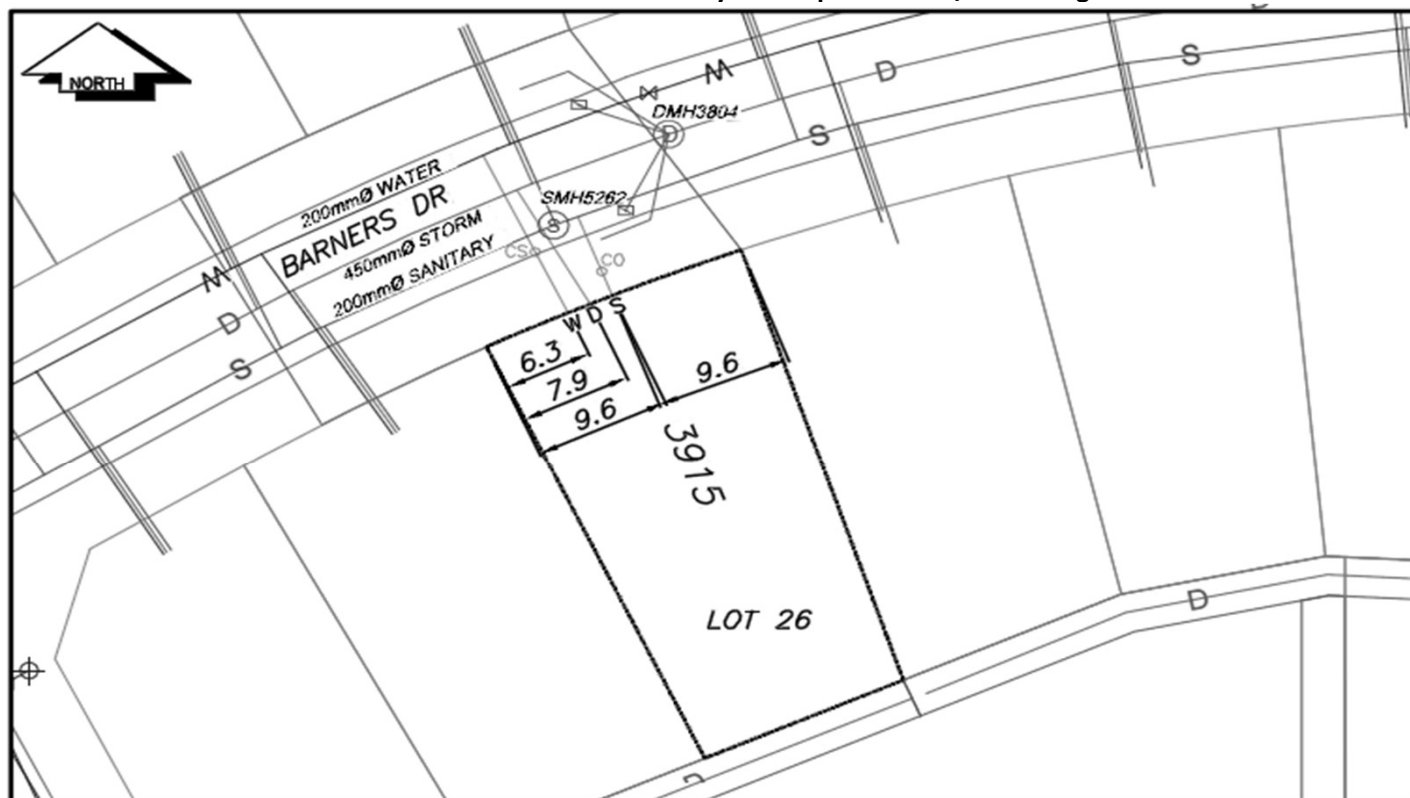

CS	CURB STOP	W	WATER SERVICE	S	STORM SERVICE
CO	CLEAN OUT	S	SANITARY SERVICE	G	GAS
WV	WATER VALVE	FH	FIRE HYDRANT	ENC	ENCUMBRANCE

NOT TO SCALE