

City of Prince George

HISTORY SHEET

PID: ~~027662900~~ 029565952

Scale: 1:1500

Legal: ~~LOT 3~~ Lot 1 D.L. 485

PLAN ~~BCP~~38207 EPP50761

Address: 988 GREAT STREET

Sanitary Connection:#	SIZE: 100mmØ	MATERIAL: N/A	INV. N/A	CONNECTED - YES
-----------------------	--------------	---------------	----------	-----------------

Water Connection:#	SIZE: 150mmØ	MATERIAL: A.C.	INV. m	METER
--------------------	--------------	----------------	--------	-------

Storm Connection:#	SIZE	375mmØ	MATERIAL: PVC	INV.	590.93m	CONNECTED
--------------------	------	--------	---------------	------	---------	-----------

Cash Receipt No's:	WATER	SANITARY	STORM
--------------------	-------	----------	-------

CURB FROM PROPERTY LINE	5.0m	PAVEMENT WIDTH	13.0m
-------------------------	------	----------------	-------

B.C. HYDRO	N/A	U/G CONNECTION
------------	-----	----------------

B.C. TELEPHONE	N/A	U/G CONNECTION
----------------	-----	----------------


B.C. GAS	N/A
----------	-----

Information Sheets: REF. DWGS. L&M ENGINEERING LIMITED JOB NO. 1126-13-03.3 (001AB-402AB)

Comments: CS₀ CURB STOP ——— SDW WATER SERVICE ———— HYDRO SERVICE ———— STORM MAIN ———— GAS
CO CLEAN OUT ——— SDW STORM SERVICE ———— CABLE SERVICE ———— SANITARY MAIN
————— SDW SANITARY SERVICE ———— TELECOMMUNICATIONS ———— WATER MAIN ———— ELECTRICAL

THE INFORMATION CONTAINED HEREIN IS FOR INTERNAL USE ONLY.

NOT TO BE RELIED UPON UNLESS CONFIRMED BY THE SITE INSPECTION AND/OR INVESTIGATION

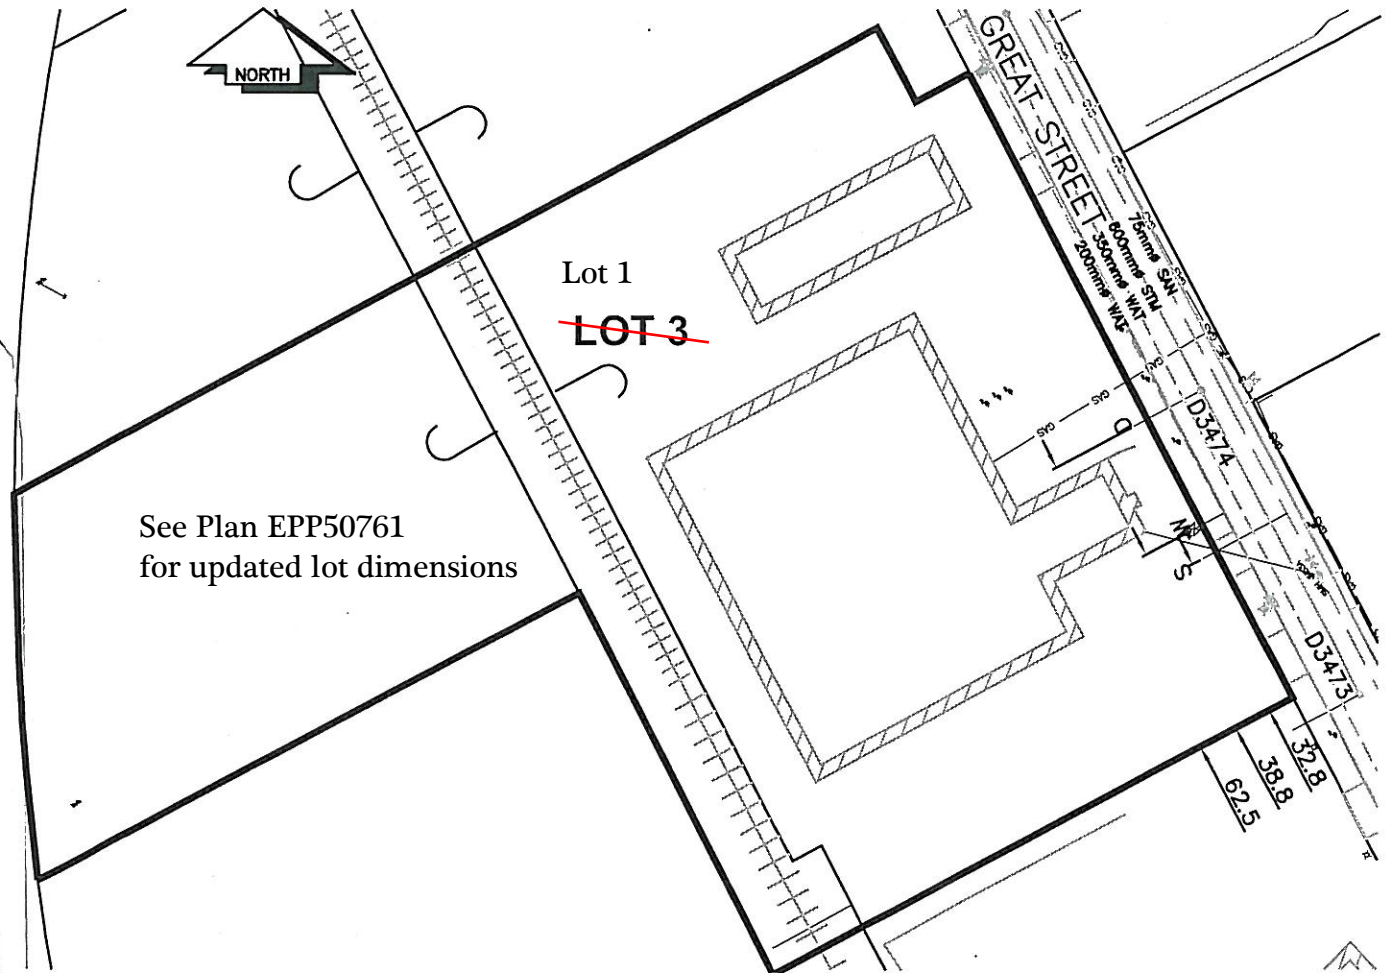

[illegible]

SANITARY HISTORY:

[illegible]

WATER HISTORY:

[illegible]

STORM HISTORY:

SERVICE IS PROVIDED 3m INTO PROPERTY TO BE CONNECTED IN FUTURE BY OWNER