



City of Prince George History Sheet

PID:	029580854
MU:	101801
WO:	79670/89779

Civic Address: 2050 Bittner Rd E

Legal Description: Lot: 1 District Lot: 633 Plan: EPP48236


Service Type	Diameter (mm)	Material	Invert Elev at main (m)	Invert Elev at property line (m)	Invert Elev at service end (m)	Distance into property (m)	Installation Date
Sanitary (Lot 1)	100mm	PVC	-	-	-	-	January 1977
Water	20mm	Copper	-	-	-	-	August 2014
Storm	N/A	N/A	-	-	-	-	

Service Connection Location				Sanitary (m)	Storm (m)
Distance from downstream San MH	1749	towards upstream San MH	1138	5.00	
Distance from downstream Stm MH	-	towards upstream Stm MH	-		

Power	Size	Communications	Size	Cable	Size	Gas	Size
BC Hydro	-	Telus	-	Shaw	-	FortisBC	-
Overhead Service		Overhead Service		Overhead Service			

Installed by:	City of Prince George forces	Survey Date:	-
Comments:			

NOT TO SCALE The information contained herein is for internal use only.
Not to be relied on unless confirmed by site inspection and/or investigation.

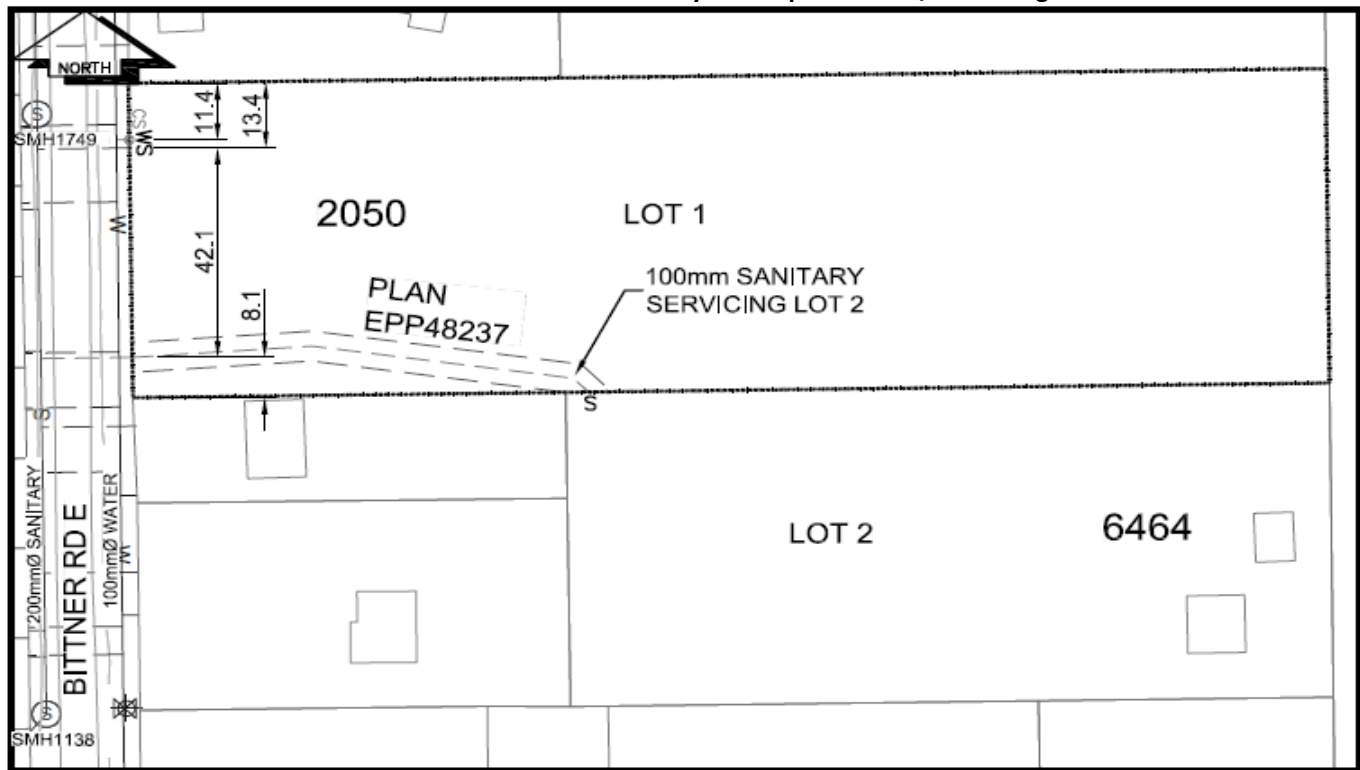

CS ^o CURB STOP	---S--- WATER SERVICE	---S--- STORM SERVICE
CO ^o CLEAN OUT	---S--- SANITARY SERVICE	---G--- GAS
⊗ WATER VALVE	⊗ FIRE HYDRANT	--- ENCUMBERANCE

NOT TO SCALE