



City of Prince George
History Sheet

PID:	029610508
SD/MU:	MU102070
WO:	MU102511

Civic Address: 525 Alward Street

Legal Description: Lot A Block 67 District Lot 343 Cariboo District Plan 1268 Parcel A (CA4518199), Block 67, District Lot 343, Cariboo District, Plan 1268


Service Type	Diameter (mm)	Material	Invert Elev at main (m)	Invert Elev at property line (m)	Invert Elev at service end (m)	Distance into property (m)	Installation Date
Sanitary	100mm	PVC	586.90	587.01	587.12	4.54	2022
Water	50mm	Copper	587.26	587.93	587.93	4.54	2022
Storm	200mm	PVC	587.90	587.91	588.09	14.8	2022

Service Connection Location				Sanitary (m)	Storm (m)
Distance from upstream San MH	984	towards downstream San MH	2672	14.27	-
Distance from downstream Stm MH	N/A	towards upstream Stm MH	N/A	-	0.00

Power	Size	Communications	Size	Cable	Size	Gas	Size
BC Hydro	2x100mm DB2	Telus	2x100mm DB2	Shaw	N/A	FortisBC	26mm
Underground Service		Underground Service					

Installed by:	Datoff Bros Construction	Survey Date:	2022
Comments:			

NOT TO SCALE The information contained herein is for internal use only.
Not to be relied on unless confirmed by site inspection and/or investigation.

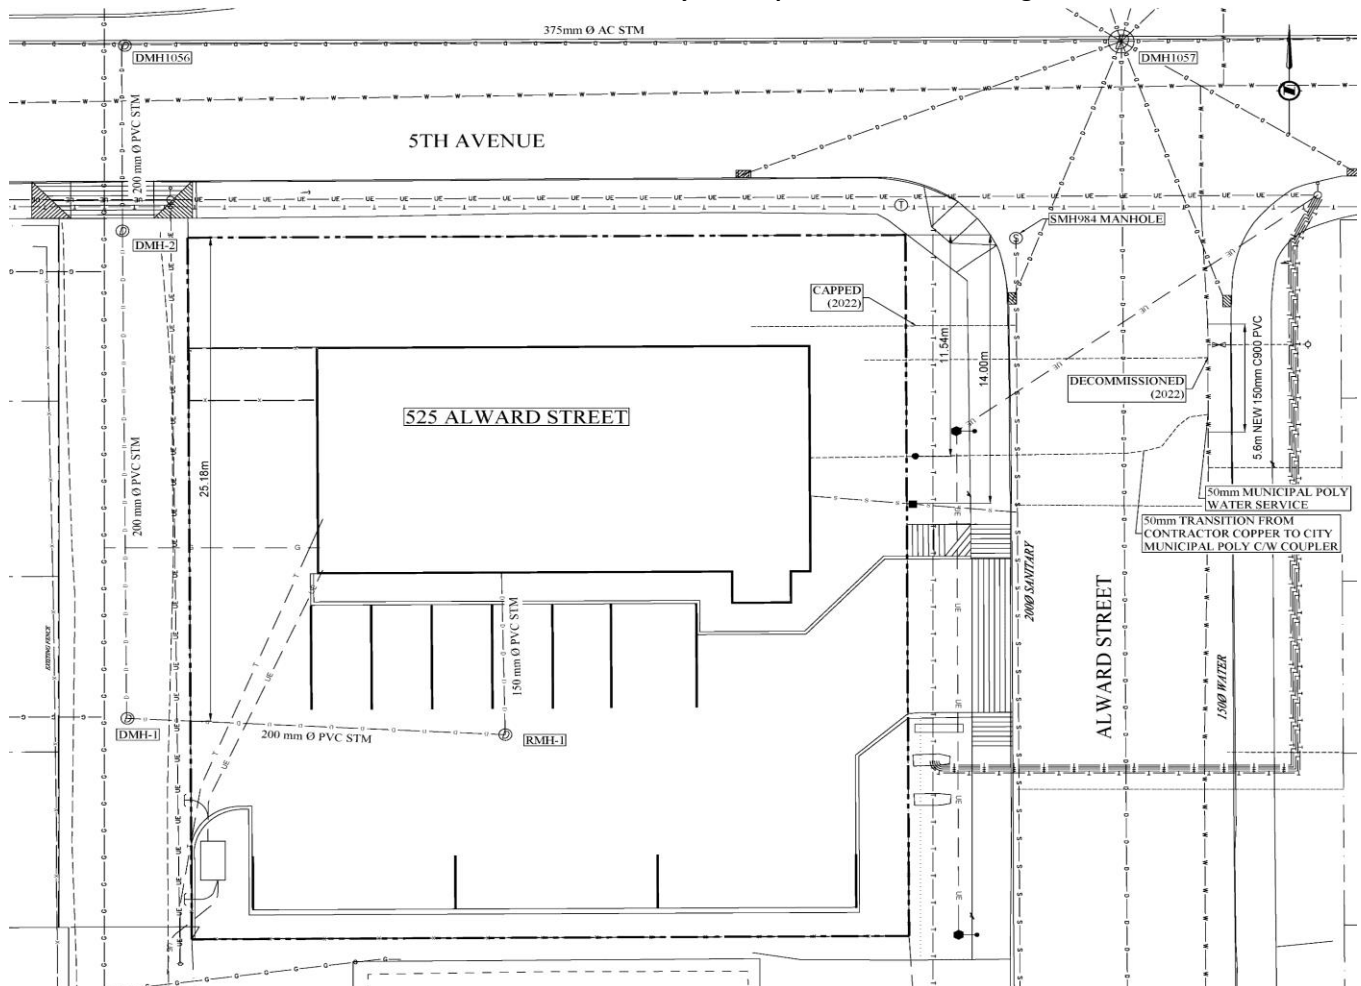

NOT TO SCALE