

# City of Prince George

## HISTORY SHEET

PID: 029-621-887

Scale: 1:1000

Legal: LOT A

D.L.: 4045

PLAN: EPP52296

Address: 4626 AVTAR PL

Sanitary Connection:# SIZE: 100mmØ MATERIAL: PVC INV. 607.06m CONNECTED

Water Connection:# SIZE: 19mmØ MATERIAL: copper INV. 606.29m METER

Storm Connection:# SIZE: 100mmØ MATERIAL: PVC INV. 607.01m CONNECTED

Cash Receipt No's: WATER SANITARY STORM

CURB FROM PROPERTY LINE 5m PAVEMENT WIDTH 10m

B.C. HYDRO 75mm DB2

B.C. TELEPHONE 100mm DB2


TERASEN 42 PROP/P.E.

Information Sheets: REFERENCE DRAWINGS L&M ENGINEERING LIMITED JOB NO. 1256-04-04

Comments: CS<sub>o</sub> CURB STOP CO CLEAN OUT SDW WATER SERVICE STORM SERVICE SANITARY SERVICE HYDRO SERVICE CABLE SERVICE TELECOMMUNICATIONS GAS ELECTRICAL

THE INFORMATION CONTAINED HEREIN IS FOR INTERNAL USE ONLY.

NOT TO BE RELIED UPON UNLESS CONFIRMED BY THE SITE INSPECTION AND/OR INVESTIGATION

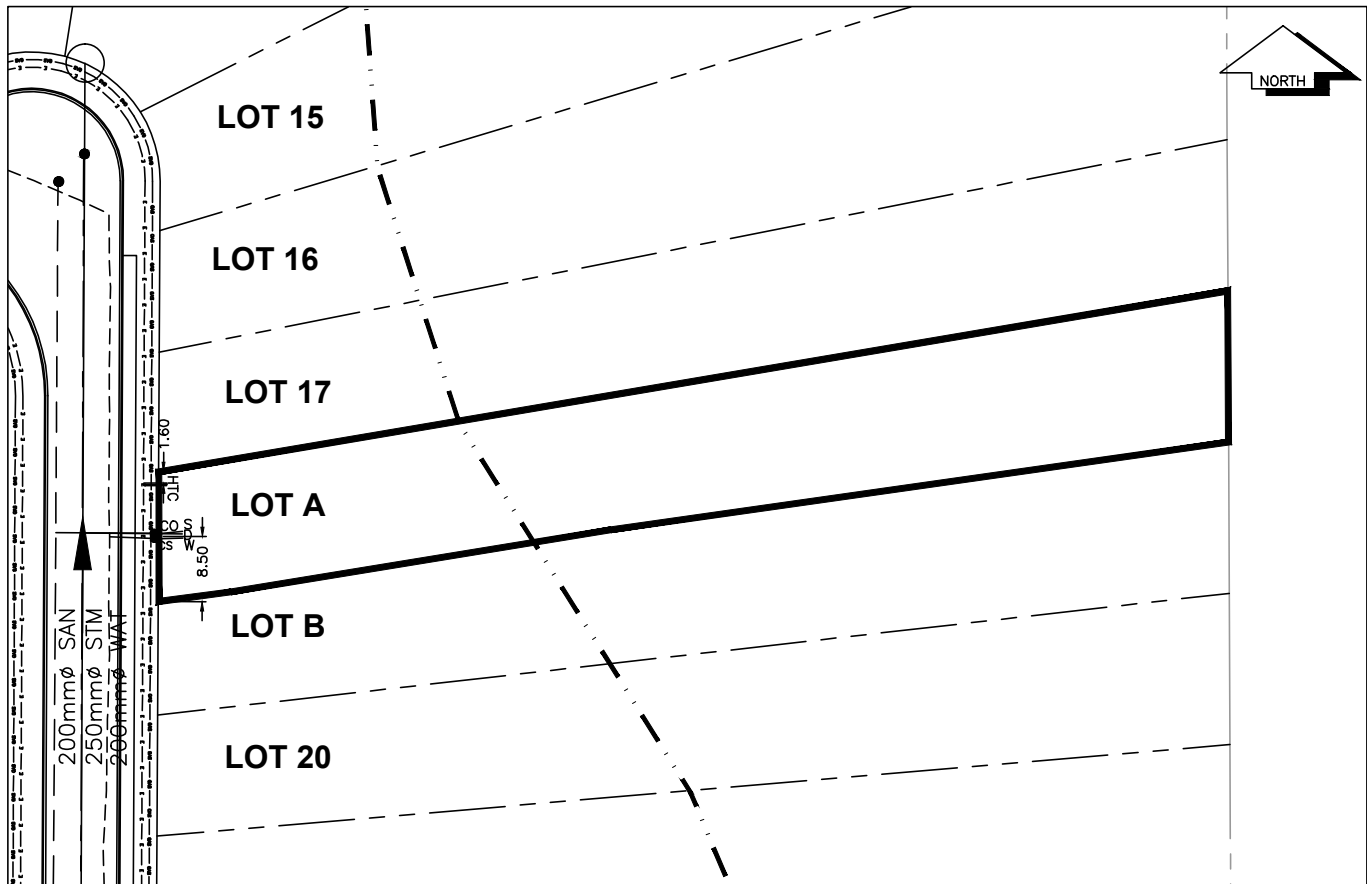

SANITARY, STORM & WATER SERVICE INVERTS	SANITARY	WATER	STORM
1. Distance from San. M.H. <u>5246</u> toward San. M.H. <u>5247</u> to lot service connection point is:	69m	N/A	N/A
1a.Distance from Stm. M.H. <u>3809</u> toward Stm. M.H. <u>3810</u> to lot service connection point is:	N/A	N/A	73m
2. Main Size at connection point is	200mm	200mm	250mm
3. Invert of main at conn. stub point is	606.53m	605.85m	606.44m
4. Invert at service end is	607.17m	606.47m	607.17m
5. Cut at property line in meters	2.39m	3.20m	2.44m
6. Survey Date: OCT 2012    Book Ref.:1256-04-04    By:ALLNORTH			

**SANITARY HISTORY:**

Installed By: Klein and Sons Construction

**WATER HISTORY:**

Installed By: Klein and Sons Construction

**STORM HISTORY:**

Installed By: Klein and Sons Construction