

City of Prince George

HISTORY SHEET

PID: 029-639-212

Scale: 1:500

Legal: LOT 14

D.L.: 905

PLAN: EPP51089

Address: 2466 GRAFTON PL

Sanitary Connection:# SIZE: 100mmØ MATERIAL: PVC INV. AT RL 724.64m CONNECTED

Water Connection:# SIZE: 19mmØ MATERIAL: COPPER INV. AT RL 724.66m CONNECTED

Storm Connection:# SIZE: 100mmØ MATERIAL: PVC INV. AT RL 724.64m CONNECTED

Cash Receipt No's: WATER SANITARY STORM

CURB FROM PROPERTY LINE 5m PAVEMENT WIDTH 10m

HYDRO 75mm DB2 U/G CONNECTION ✓


TELEPHONE 50mm DB2 U/G CONNECTION ✓

GAS 42 PROP/P.E.

Information Sheets: REF. DWGS. L&M ENGINEERING LTD. JOB. 1273-19 DWGS.

Comments: CS CURB STOP CO CLEAN OUT SOW WATER SERVICE STORM SERVICE SANITARY SERVICE HYDRO SERVICE CABLE SERVICE TELECOMMUNICATIONS GAS ELECTRICAL

THE INFORMATION CONTAINED HEREIN IS FOR INTERNAL USE ONLY.
NOT TO BE RELIED UPON UNLESS CONFIRMED BY THE SITE INSPECTION AND/OR INVESTIGATION

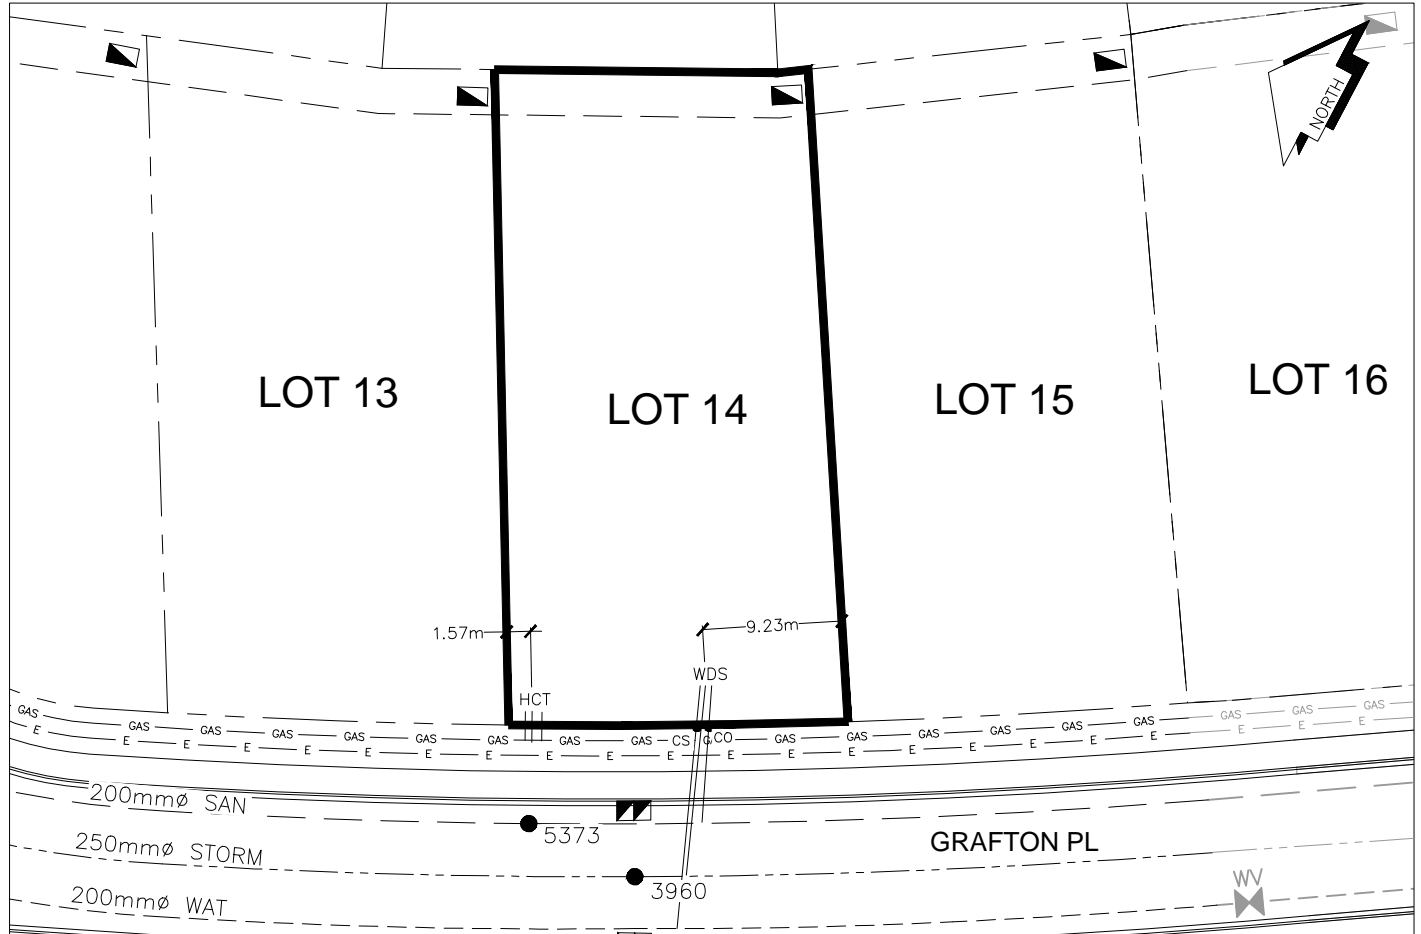

SANITARY, STORM & WATER SERVICE INVERTS	SANITARY	WATER	STORM
1. Distance from San. M.H. <u>5373</u> toward San. M.H. <u>5236</u> to lot service connection point is:	11.35m	N/A	N/A
1a.Distance from Stm. M.H. <u>3960</u> toward Stm. M.H. <u>3796</u> to lot service connection point is:	N/A	N/A	3.29m
2. Main Size at connection point is	200mmØ	200mmØ	250mmØ
3. Invert of service at main conn. stub point is	724.23m	723.75m	724.29m
4. Invert at service end is	724.69m	724.72m	724.68m
5. Cover at property line in meters	2.75m	2.84m	2.77m
6. Survey Date:JUNE 2015 Book Ref.:1273-19 By:L&M ENGINEERING			

SANITARY HISTORY:

DATE INSTALLED: JUNE 2015

INSTALLED BY: JOE ROBERTS CONSTRUCTION & CONSULTING SERVICE LTD.

WATER HISTORY:

DATE INSTALLED: JUNE 2015

INSTALLED BY: JOE ROBERTS CONSTRUCTION & CONSULTING SERVICE LTD.

STORM HISTORY:

DATE INSTALLED: JUNE 2015

INSTALLED BY: JOE ROBERTS CONSTRUCTION & CONSULTING SERVICE LTD.