

City of Prince George

HISTORY SHEET

PID: 029-639-298

Scale: 1:500

Legal: LOT 22

D.L.: 905

PLAN: EPP51089

Address: 2447 CHANCELLOR BLVD

Sanitary Connection:#	SIZE: 100mmØ	MATERIAL: PVC	INV. AT \mathbb{R} 721.98m	CONNECTED
-----------------------	--------------	---------------	------------------------------	-----------

Water Connection:#	SIZE: 19mmØ	MATERIAL: COPPER	INV. AT \mathbb{R} 722.01m	CONNECTED
--------------------	-------------	------------------	------------------------------	-----------

Storm Connection:#	SIZE: 100mmØ	MATERIAL: PVC	INV. AT \mathbb{R} 721.98m	CONNECTED
--------------------	--------------	---------------	------------------------------	-----------

Cash Receipt No's:	WATER	SANITARY	STORM
--------------------	-------	----------	-------

CURB FROM PROPERTY LINE	6m	PAVEMENT WIDTH	13m
-------------------------	----	----------------	-----

HYDRO	75mm DB2	U/G CONNECTION	✓
-------	----------	----------------	---

TELEPHONE	50mm DB2	U/G CONNECTION	✓
-----------	----------	----------------	---


GAS	42 PROP/P.E.
-----	--------------

Information Sheets: REF. DWGS. L&M ENGINEERING LTD. JOB. 1273-19 DWGS.

Comments:

CS CURB STOP	SDW	WATER SERVICE	HYDRO SERVICE	GAS	GAS
CO CLEAN OUT		STORM SERVICE	CABLE SERVICE	E	ELECTRICAL
		SANITARY SERVICE	TELECOMMUNICATIONS		

**THE INFORMATION CONTAINED HEREIN IS FOR INTERNAL USE ONLY.
NOT TO BE RELIED UPON UNLESS CONFIRMED BY THE SITE INSPECTION AND/OR INVESTIGATION**

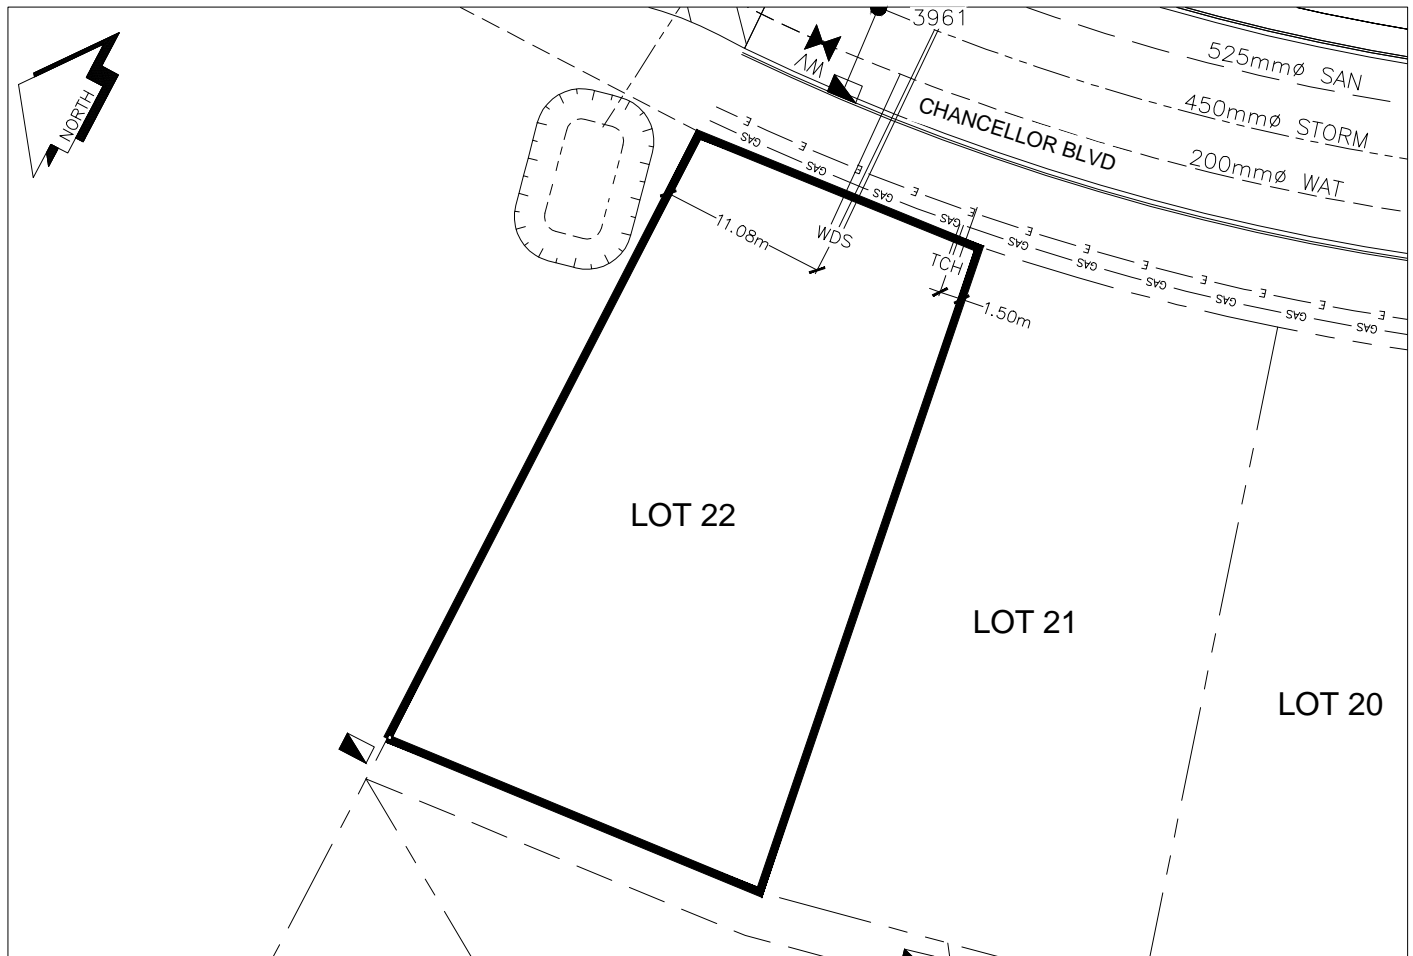

SANITARY, STORM & WATER SERVICE INVERTS	SANITARY	WATER	STORM
1. Distance from San. M.H. <u>5370</u> toward San. M.H. <u>5371</u> to lot service connection point is:	7.83m	N/A	N/A
1a.Distance from Stm. M.H. <u>3961</u> toward Stm. M.H. <u>3962</u> to lot service connection point is:	N/A	N/A	4.01m
2. Main Size at connection point is	525mmØ	200mmØ	450mmØ
3. Invert of service at main conn. stub point is	721.58m	721.28m	721.39m
4. Invert at service end is	722.04m	722.07m	722.05m
5. Cover at property line in meters	2.64m	2.76m	2.65m
6. Survey Date:JUNE 2015 Book Ref.:1273-19 By:L&M ENGINEERING			

SANITARY HISTORY:

DATE INSTALLED: JUNE 2015

INSTALLED BY: JOE ROBERTS CONSTRUCTION & CONSULTING SERVICE LTD.

WATER HISTORY:

DATE INSTALLED: JUNE 2015

INSTALLED BY: JOE ROBERTS CONSTRUCTION & CONSULTING SERVICE LTD.

STORM HISTORY:

DATE INSTALLED: JUNE 2015

INSTALLED BY: JOE ROBERTS CONSTRUCTION & CONSULTING SERVICE LTD.