



City of Prince George History Sheet

PID:	029640555
SD/MU:	
WO:	

Civic Address: 4715 Stauble Rd

Legal Description: Lot: A District Lot: 4048 Plan: EPP5


Service Type	Diameter (mm)	Material	Invert Elev at main (m)	Invert Elev at property line (m)	Invert Elev at service end (m)	Distance into property (m)	Installation Date
Sanitary (North)	100mm	PVC	-	790.87	-	-	January 1981
Sanitary (East)	100mm	PVC	-	790.46	-	-	January 1978
Water (North)	20mm	Copper	-	-	-	-	January 1981
Water (East)	20mm	Copper	-	-	-	-	January 1992
Storm	N/A	N/A	-	-	-	-	

Service Connection Location				Sanitary (m)	Storm (m)
Distance from downstream San MH	461	rd's upstream San MH	514	-	
Distance from downstream Stm MH	-	towards upstream Stm MH	-		

Power	Size	Communications	Size	Cable	Size	Gas	Size
BC Hydro	-	Telus	-	Shaw	-	FortisBC	-
Underground Service		Underground Service		Underground Service			

Installed by:	Survey Date:	-
Comments:		

NOT TO SCALE The information contained herein is for internal use only.
Not to be relied on unless confirmed by site inspection and/or investigation.

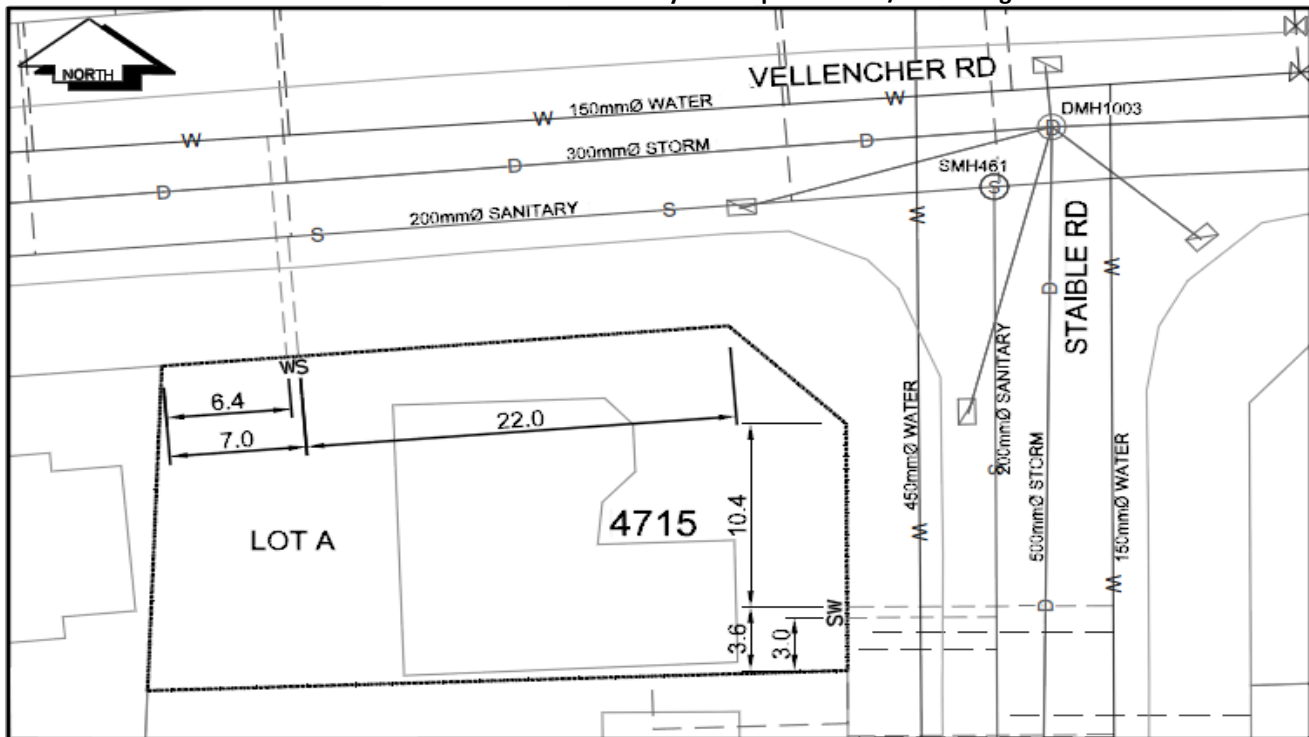

CS	CURB STOP	---	WATER SERVICE	---	STORM SERVICE
CO	CLEAN OUT	---	SANITARY SERVICE	---	GAS
⊗	WATER VALVE	⊗	FIRE HYDRANT	---	ENCUMBERANCE

NOT TO SCALE