
City of Prince George HISTORY SHEET

PID: 029-723-21 3	}				Scal	e: 1:500		
Legal: LOT 1					D.L.	: 2425	PLAN:	EPP55596
Address: 5494 WOO E	VALLEY DRIVE	≣						
Sanitary Connection:#		SIZE:	100mmØ	MATERIAL:	PVC	INV. @ PL	763.13m	CONNECTED
Water Connection:#		SIZE:	19mmØ	MATERIAL:	COPPER	INV. @ PL	763.39m	CONNECTED
Storm Connection:#		SIZE	100mmØ	MATERIAL	PVC	INV. @ PL	763.32m	CONNECTED
Cash Receipt No's:			WATER		SANITARY		STORM	
CURB FROM PROPER	TY LINE	5m				PAV	EMENT WIDTH	10m
HYDRO	75mm DB2				U/G CONNECTI	ON ✓	<i>,</i>	
TELEPHONE	50mm DB2				U/G CONNECTI	ON ✓	/	
GAS	42 PROP /P.E	<u> </u>						
Information Sheets:	REF DWGS L&M ENGINEERING LTD. JOB 1107-09-04 DWGS (001-302)							
Comments:	CS CURB STOP WATER SERVICE THYDRO SERVICE GAS CO CLEAN OUT SANITARY SERVICE TELECOMMUNICATIONS ELECTRICATIONS						- GAS - ELECTRICAL	

THE INFORMATION CONTAINED HEREIN IS FOR INTERNAL USE ONLY. NOT TO BE RELIED UPON UNLESS CONFIRMED BY THE SITE INSPECTION AND/OR INVESTIGATION

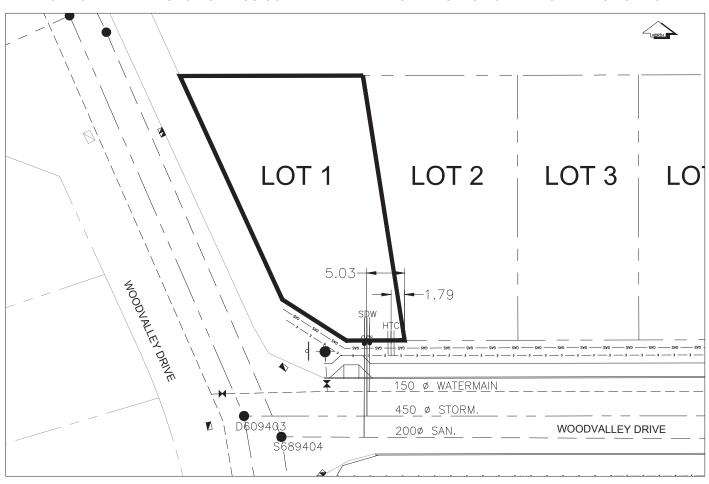

SANITARY, STORM & WATER SERVICE INVERTS	SANITARY	WATER	STORM						
1. Distance from San. M.H. <u>689404</u> toward San. M.H. <u>689403</u> to lot service connection point is:	10.94m	N/A	N/A						
1a.Distance from Stm. M.H. 609403 toward Stm. M.H. 689404 to lot service connection point is:	N/A	N/A	16.27m						
2. Main Size at connection point is	200mmØ	150mmØ	450mmØ						
3. Invert of main at conn. stub point is	762.22m	762.42m	761.14m						
4. Invert at service end is	763.28m	763.43m	763.38m						
5. Cover at property line in meters	2.40m	2.23m	2.21m						
6. Survey Date: NOV 2007 Book Ref.:1107-09-03 By:FORESIGHT									
	1								
SANITARY HISTORY:									
DATE MAIN INSTALLED: 1995									
DATE SERVICES EXTENDED: SEPT 2007									
INSTALLED BY: WESTERN INDUSTRIAL CONTRACTORS LTD.									
WATER HISTORY:									
DATE MAIN INSTALLED: 1995									
DATE SERVICES EXTENDED: SEPT 2007 INSTALLED BY: WESTERN INDUSTRIAL CONTRACTORS LTD.									
INOTALLED BY. WESTERN INDOSTRIAL SONT VISTORIO ETD.									
STORM HISTORY:									
DATE MAIN INSTALLED: 1995									
DATE SERVICES EXTENDED: SEPT 2007									
INSTALLED BY: WESTERN INDUSTRIAL CONTRACTORS LTD.									