
## City of Prince George HISTORY SHEET

| PID: <b>029-723-22</b>     | 1   |       |        |           | Scale          | e: 1:500    |                       |           |
|----------------------------|---|-------|--------|-----------|----------------|-------------|-----------------------|-----------|
| Legal: LOT 2               |   |       |        |           | D.L.:          | 2425        | PLAN:                 | EPP55596  |
| Address: <b>5480 WOO</b> I | OVALLEY DRIV  | E     |        |           |                |             |                       |           |
| Sanitary Connection:#      |   | SIZE: | 100mmØ | MATERIAL: | PVC            | INV. @ PL   | 763.32m               | CONNECTED |
| Water Connection:#         |   | SIZE: | 19mmØ  | MATERIAL: | COPPER         | INV. @ PL   | 763.31m               | CONNECTED |
| Storm Connection:#         |   | SIZE  | 100mmØ | MATERIAL  | PVC            | INV. @ PL   | 763.33m               | CONNECTED |
| Cash Receipt No's:         |   |       | WATER  |           | SANITARY       |             | STORM                 |           |
| CURB FROM PROPERTY LINE 5m |   |       |        |           | PAV            | EMENT WIDTH | 10m                   |           |
| HYDRO                      | 75mm DB2  |       |        |           | U/G CONNECTION | ON <        | /                     |           |
| TELEPHONE                  | 50mm DB2  |       |        |           | U/G CONNECTION | ON 🗸        | /                     |           |
| GAS                        | 42 PROP /P.I  | E     |        |           |                |             |                       |           |
| Information Sheets:        | REF DWGS L&M ENGINEERING LTD. JOB 1107-09-04 DWGS (001-302)   |       |        |           |                |             |                       |           |
| Comments:                  | CS CURB STOP WATER SERVICE THYDRO SERVICE GAS  CO CLEAN OUT SANITARY SERVICE TELECOMMUNICATIONS ELECTRIC. |       |        |           |                |             | - GAS<br>- ELECTRICAL |           |

## THE INFORMATION CONTAINED HEREIN IS FOR INTERNAL USE ONLY. NOT TO BE RELIED UPON UNLESS CONFIRMED BY THE SITE INSPECTION AND/OR INVESTIGATION

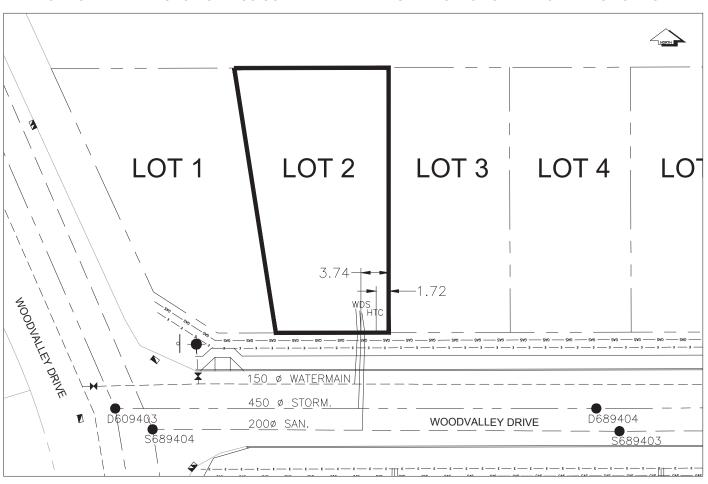

| SANITARY, STORM & WATER SERVICE INVERTS   | SANITARY | WATER   | STORM   |  |  |  |  |  |  |  |
|---|----------|---------|---------|--|--|--|--|--|--|--|
| 1. Distance from San. M.H. <u>689404</u> toward San. M.H. <u>689403</u> to lot service connection point is: | 27.88m   | N/A     | N/A     |  |  |  |  |  |  |  |
| 1a.Distance from Stm. M.H. <u>609403</u> toward Stm. M.H. <u>689404</u> to lot service connection point is: | N/A      | N/A     | 32.50m  |  |  |  |  |  |  |  |
| Main Size at connection point is  | 200mmØ   | 150mmØ  | 450mmØ  |  |  |  |  |  |  |  |
| 3. Invert of main at conn. stub point is  | 762.01m  | 762.26m | 761.00m |  |  |  |  |  |  |  |
| 4. Invert at service end is   | 763.43m  | 763.53m | 763.42m |  |  |  |  |  |  |  |
| 5. Cover at property line in meters   | 2.37     | 2.46m   | 2.36m   |  |  |  |  |  |  |  |
| 6. Survey Date: NOV 2007 Book Ref.:1107-09-03 By:FORESIGHT  |          |         |         |  |  |  |  |  |  |  |
|   |          |         |         |  |  |  |  |  |  |  |
|   |          |         |         |  |  |  |  |  |  |  |
| SANITARY HISTORY:   |          |         |         |  |  |  |  |  |  |  |
| DATE MAIN INSTALLED: 1995   |          |         |         |  |  |  |  |  |  |  |
| DATE SERVICES EXTENDED: SEPT 2007   |          |         |         |  |  |  |  |  |  |  |
| INSTALLED BY: WESTERN INDUSTRIAL CONTRACTORS LTD.   |          |         |         |  |  |  |  |  |  |  |
|   |          |         |         |  |  |  |  |  |  |  |
|   |          |         |         |  |  |  |  |  |  |  |
| WATER HISTORY:  |          |         |         |  |  |  |  |  |  |  |
| DATE MAIN INSTALLED: 1995   |          |         |         |  |  |  |  |  |  |  |
|   |          |         |         |  |  |  |  |  |  |  |
| DATE SERVICES EXTENDED: SEPT 2007 INSTALLED BY: WESTERN INDUSTRIAL CONTRACTORS LTD.                         |          |         |         |  |  |  |  |  |  |  |
| INSTALLED BT. WESTERN INDUSTRIAL CONTRACTORS ETD.   |          |         |         |  |  |  |  |  |  |  |
|   |          |         |         |  |  |  |  |  |  |  |
|   |          |         |         |  |  |  |  |  |  |  |
| STORM HISTORY:  |          |         |         |  |  |  |  |  |  |  |
| DATE MAIN INSTALLED: 1995   |          |         |         |  |  |  |  |  |  |  |
| DATE SERVICES EXTENDED: SEPT 2007   |          |         |         |  |  |  |  |  |  |  |
| INSTALLED BY: WESTERN INDUSTRIAL CONTRACTORS LTD.   |          |         |         |  |  |  |  |  |  |  |
|   |          |         |         |  |  |  |  |  |  |  |
|   |          |         |         |  |  |  |  |  |  |  |
