

City of Prince George

HISTORY SHEET

PID: 029-723-230

Scale: 1:500

Legal: LOT 3

D.L.: 2425

PLAN: EPP55596

Address: 5472 WOODVALLEY DRIVE

| | | | | | |
|-----------------------|--------------|---------------|-----------|---------|-----------|
| Sanitary Connection:# | SIZE: 100mmØ | MATERIAL: PVC | INV. @ PL | 763.41m | CONNECTED |
|-----------------------|--------------|---------------|-----------|---------|-----------|

| | | | | | |
|--------------------|-------------|------------------|-----------|---------|-----------|
| Water Connection:# | SIZE: 19mmØ | MATERIAL: COPPER | INV. @ PL | 763.49m | CONNECTED |
|--------------------|-------------|------------------|-----------|---------|-----------|

| | | | | | |
|--------------------|--------------|---------------|-----------|---------|-----------|
| Storm Connection:# | SIZE: 100mmØ | MATERIAL: PVC | INV. @ PL | 763.47m | CONNECTED |
|--------------------|--------------|---------------|-----------|---------|-----------|

| | | | |
|--------------------|-------|----------|-------|
| Cash Receipt No's: | WATER | SANITARY | STORM |
|--------------------|-------|----------|-------|

| | | | |
|-------------------------|----|----------------|-----|
| CURB FROM PROPERTY LINE | 5m | PAVEMENT WIDTH | 10m |
|-------------------------|----|----------------|-----|

| | | | |
|-------|----------|----------------|---|
| HYDRO | 75mm DB2 | U/G CONNECTION | ✓ |
|-------|----------|----------------|---|

| | | | |
|-----------|----------|----------------|---|
| TELEPHONE | 50mm DB2 | U/G CONNECTION | ✓ |
|-----------|----------|----------------|---|


| | | | |
|-----|--------------|--|--|
| GAS | 42 PROP /P.E | | |
|-----|--------------|--|--|

Information Sheets: REF DWGS L&M ENGINEERING LTD. JOB 1107-09-04 DWGS (001-302)

| | | | | |
|-----------|------------------------------|--|--|-------------------|
| Comments: | CS CURB STOP CO CLEAN OUT | WATER SERVICE STORM SERVICE SANITARY SERVICE | HYDRO SERVICE CABLE SERVICE TELECOMMUNICATIONS | GAS ELECTRICAL |
|-----------|------------------------------|--|--|-------------------|

THE INFORMATION CONTAINED HEREIN IS FOR INTERNAL USE ONLY.

NOT TO BE RELIED UPON UNLESS CONFIRMED BY THE SITE INSPECTION AND/OR INVESTIGATION

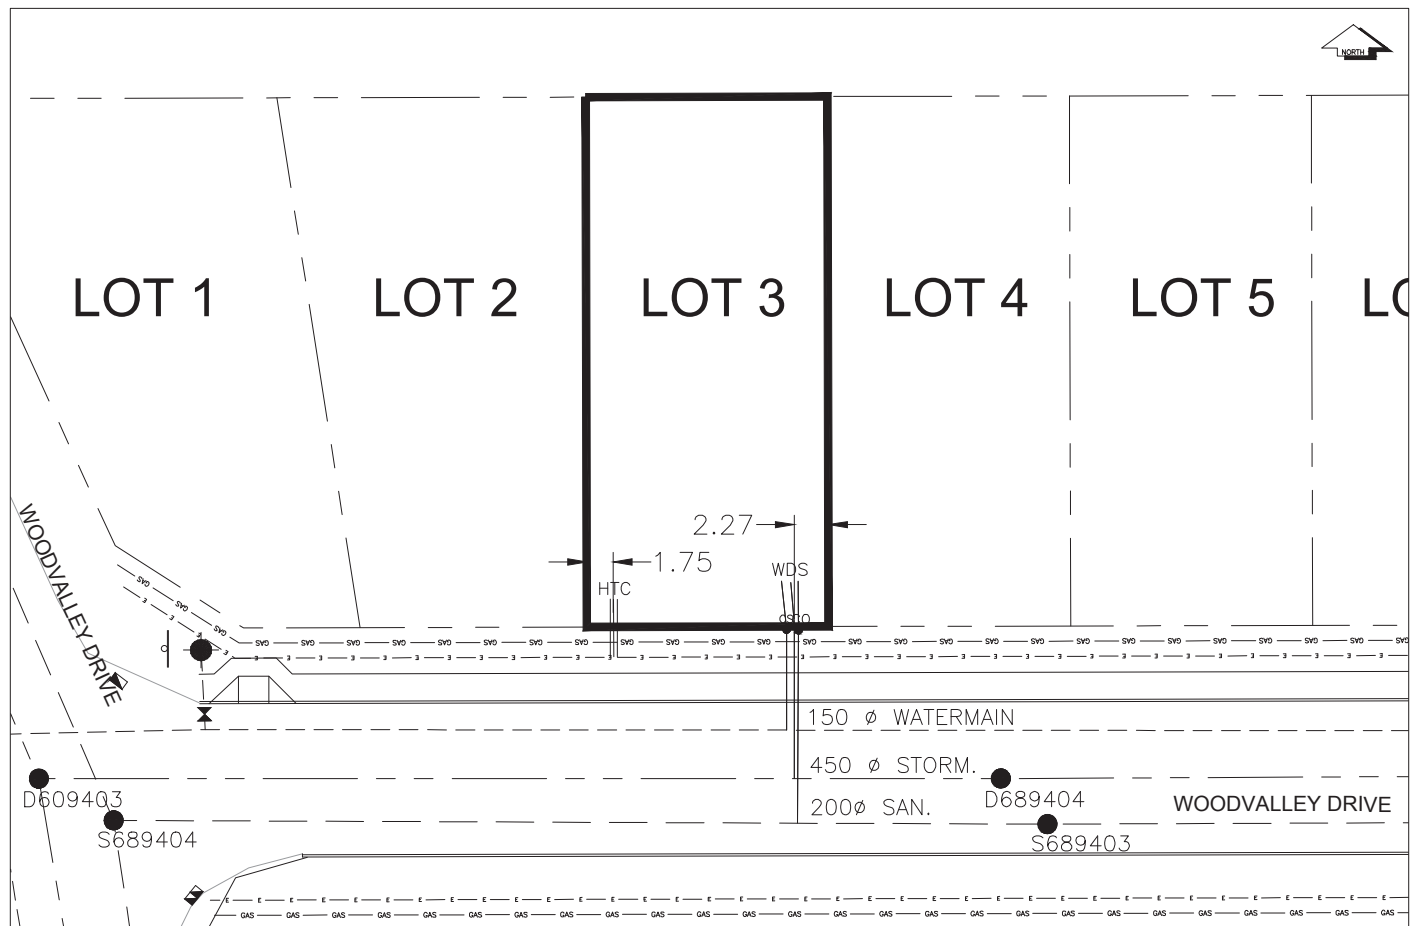

| SANITARY, STORM & WATER SERVICE INVERTS | SANITARY | WATER | STORM |
|---|----------|---------|---------|
| 1. Distance from San. M.H. <u>689404</u> toward San. M.H. <u>689403</u> to lot service connection point is: | 45.24m | N/A | N/A |
| 1a.Distance from Stm. M.H. <u>609403</u> toward Stm. M.H. <u>689404</u> to lot service connection point is: | N/A | N/A | 49.96m |
| 2. Main Size at connection point is | 200mmØ | 150mmØ | 450mmØ |
| 3. Invert of main at conn. stub point is | 761.86m | 762.36m | 760.88m |
| 4. Invert at service end is | 763.71m | 763.58m | 763.71m |
| 5. Cover at property line in meters | 2.49m | 2.49m | 2.42m |
| 6. Survey Date:NOV 2007 Book Ref.:1107-09-03 By:FORESIGHT | | | |
| | | | |
| | | | |
SANITARY HISTORY:

DATE MAIN INSTALLED: 1995

DATE SERVICES EXTENDED: SEPT 2007

INSTALLED BY: WESTERN INDUSTRIAL CONTRACTORS LTD.

WATER HISTORY:

DATE MAIN INSTALLED: 1995

DATE SERVICES EXTENDED: SEPT 2007

INSTALLED BY: WESTERN INDUSTRIAL CONTRACTORS LTD.

STORM HISTORY:

DATE MAIN INSTALLED: 1995

DATE SERVICES EXTENDED: SEPT 2007

INSTALLED BY: WESTERN INDUSTRIAL CONTRACTORS LTD.