
## City of Prince George HISTORY SHEET

PID:	029-723-426					Scale	: 1:500		
Legal:	LOT 22					D.L.:	2425	PLAN:	EPP55596
Address	5230 GABLE	PLACE							
Sanitary	Connection:#		SIZE:	100mmØ	MATERIAL:	PVC	INV. @ PL	763.22m	CONNECTED
Water C	onnection:#		SIZE:	19mmØ	MATERIAL:	COPPER	INV. @ PL	763.06m	CONNECTED
Storm C	onnection:#		SIZE	100mmØ	MATERIAL	PVC	INV. @ PL	763.21m	CONNECTED
Cash Re	eceipt No's:			WATER		SANITARY		STORM	
CURB F	ROM PROPER	TY LINE	5m				PAV	EMENT WIDTH	10m
HYDRO		75mm DB2				U/G CONNECTION	ON <	/	
TELEPH	ONE	50mm DB2				U/G CONNECTION	ON <	/	
GAS		42 PROP /P	.E						
Informat	ion Sheets:	R	EF DWGS		RING LTD. JOB				
Commer	nts:	CS CU	RB STOP EAN OUT		WATER SERVICI STORM SERVICI SANITARY SERV	E E /ICE	HYDRO SERVI      CABLE SERVI      TELECOMMUN      ■	CE — SAS — DE NICATIONS — " — " -	<ul><li>GAS</li><li>ELECTRICAL</li></ul>

## THE INFORMATION CONTAINED HEREIN IS FOR INTERNAL USE ONLY. NOT TO BE RELIED UPON UNLESS CONFIRMED BY THE SITE INSPECTION AND/OR INVESTIGATION

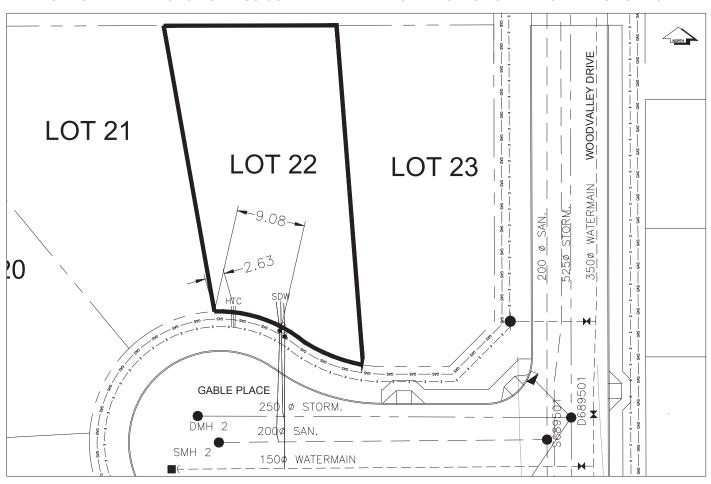

SANITARY, STORM & WATER SERVICE INVERTS	SANITARY	WATER	STORM								
1. Distance from San. M.H. SMH2 toward San. M.H. 689501 to lot service connection point is:	7.91m	N/A	N/A								
1a.Distance from Stm. M.H. <u>DMH2</u> toward Stm. M.H. <u>689501</u> to lot service connection point is:	N/A	N/A	11.34m								
2. Main Size at connection point is	200mmØ	150mmØ	250mmØ								
3. Invert of main at conn. stub point is	762.42m	762.28m	762.56m								
4. Invert at service end is	763.31m	763.17m	763.29m								
5. Cover at property line in meters	2.12m	2.36m	2.13m								
6. Survey Date: NOV 2007 Book Ref.:1107-09-03 By:FORESIGHT											
SANITARY HISTORY:											
DATE MAIN INSTALLED: SEPT 2007											
DATE SERVICES EXTENDED: SEPT 2007											
INSTALLED BY: WESTERN INDUSTRIAL CONTRACTORS LTD.											
WATER HISTORY:											
DATE MAIN INSTALLED: SEPT 2007											
DATE SERVICES EXTENDED: SEPT 2007											
INSTALLED BY: WESTERN INDUSTRIAL CONTRACTORS LTD.											
STORM HISTORY:											
DATE MAIN INSTALLED: SEPT 2007											
DATE SERVICES EXTENDED: SEPT 2007											
INSTALLED BY: WESTERN INDUSTRIAL CONTRACTORS LTD.											