
City of Prince George HISTORY SHEET

PID: 029-723-44	2				Scale	e: 1:500		
Legal: LOT 24					D.L.:	2425	PLAN:	EPP55596
Address: 5128 WOO	OVALLEY DRIVI	≣						
Sanitary Connection:#		SIZE:	100mmØ	MATERIAL:	PVC	INV. @ PL	762.65m	CONNECTED
Water Connection:#		SIZE:	19mmØ	MATERIAL:	COPPER	INV. @ PL	762.47m	CONNECTED
Storm Connection:#		SIZE	100mmØ	MATERIAL	PVC	INV. @ PL	762.54m	CONNECTED
Cash Receipt No's:			WATER		SANITARY		STORM	
CURB FROM PROPE	RTY LINE	5m				PAV	EMENT WIDTH	10m
HYDRO	75mm DB2				U/G CONNECTION	ON <		
TELEPHONE	50mm DB2				U/G CONNECTION	ON ✓	/	
GAS	42 PROP /P.E	<u> </u>						
Information Sheets:	REF DWGS L&M ENGINEERING LTD. JOB 1107-09-04 DWGS (001-302)							
Comments:	CS CURB STOP CO CLEAN OUT WATER SERVICE STORM SERVICE SANITARY SERVICE TELECOMMUNICATIONS TELECOMMUNICATIONS GAS TELECTRICA						- GAS - ELECTRICAL	

THE INFORMATION CONTAINED HEREIN IS FOR INTERNAL USE ONLY.

NOT TO BE RELIED UPON UNLESS CONFIRMED BY THE SITE INSPECTION AND/OR INVESTIGATION

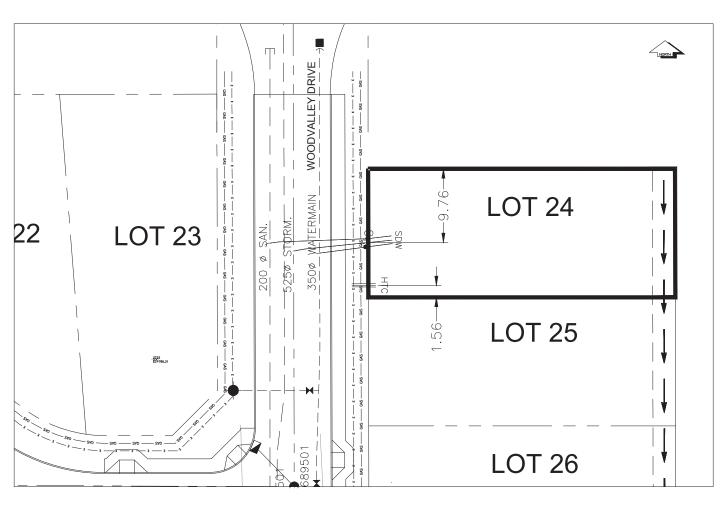

SANITARY, STORM & WATER SERVICE INVERTS	SANITARY	WATER	STORM
Distance from San. M.H toward San. M.H. <u>689501</u> to lot service connection point is:	25.73m	N/A	N/A
1a.Distance from Stm. M.H. 609501 toward Stm. M.H. DMH to lot service connection point is:	N/A	N/A	31.16m
2. Main Size at connection point is	200mmØ	350mmØ	525mmØ
3. Invert of main at conn. stub point is	760.45m	761.32m	759.43m
4. Invert at service end is	762.75m	762.85m	762.62m
5. Cover at property line in meters	2.41m	2.67m	2.52m
6. Survey Date: NOV 2007 Book Ref.:1107-09-03 By:FORESIGHT			
			1
SANITARY HISTORY:			
DATE MAIN INSTALLED: JUN 2008			
DATE SERVICES EXTENDED: JUN 2008			
INSTALLED BY: WESTERN INDUSTRIAL CONTRACTORS LTD.			
WATER HISTORY:			
DATE MAIN INSTALLED: JUN 2008			
DATE SERVICES EXTENDED: JUN 2008 INSTALLED BY: WESTERN INDUSTRIAL CONTRACTORS LTD.			
INSTALLED BY. WESTERN INDUSTRIAL CONTRACTORS LTD.			
STORM HISTORY:			
DATE MAIN INSTALLED: JUN 2008			
DATE SERVICES EXTENDED: JUN 2008			
INSTALLED BY: WESTERN INDUSTRIAL CONTRACTORS LTD.			