

# City of Prince George

## HISTORY SHEET

PID: **029-723-469**

Scale: 1:500

Legal: LOT 26

D.L.: 2425

PLAN: EPP55596

Address: **5144 WOODVALLEY DRIVE**

Sanitary Connection:#	SIZE: 100mmØ	MATERIAL: PVC	INV. @ PL	762.66m	CONNECTED
-----------------------	--------------	---------------	-----------	---------	-----------

Water Connection:#	SIZE: 19mmØ	MATERIAL: COPPER	INV. @ PL	762.40m	CONNECTED
--------------------	-------------	------------------	-----------	---------	-----------

Storm Connection:#	SIZE: 100mmØ	MATERIAL: PVC	INV. @ PL	762.65m	CONNECTED
--------------------	--------------	---------------	-----------	---------	-----------

Cash Receipt No's:	WATER	SANITARY	STORM
--------------------	-------	----------	-------

CURB FROM PROPERTY LINE	5m	PAVEMENT WIDTH	10m
-------------------------	----	----------------	-----

HYDRO	75mm DB2	U/G CONNECTION	✓
-------	----------	----------------	---


TELEPHONE	50mm DB2	U/G CONNECTION	✓
-----------	----------	----------------	---

GAS	42 PROP /P.E
-----	--------------

Information Sheets: REF DWGS L&M ENGINEERING LTD. JOB 1107-09-04 DWGS (001-302)

Comments:	CS CURB STOP CO CLEAN OUT	SDW WATER SERVICE STORM SERVICE SANITARY SERVICE	HCH HYDRO SERVICE CCH CABLE SERVICE TCH TELECOMMUNICATIONS	GAS GAS E ELECTRICAL
-----------	------------------------------	--------------------------------------------------------	------------------------------------------------------------------	-------------------------

**THE INFORMATION CONTAINED HEREIN IS FOR INTERNAL USE ONLY.  
NOT TO BE RELIED UPON UNLESS CONFIRMED BY THE SITE INSPECTION AND/OR INVESTIGATION**

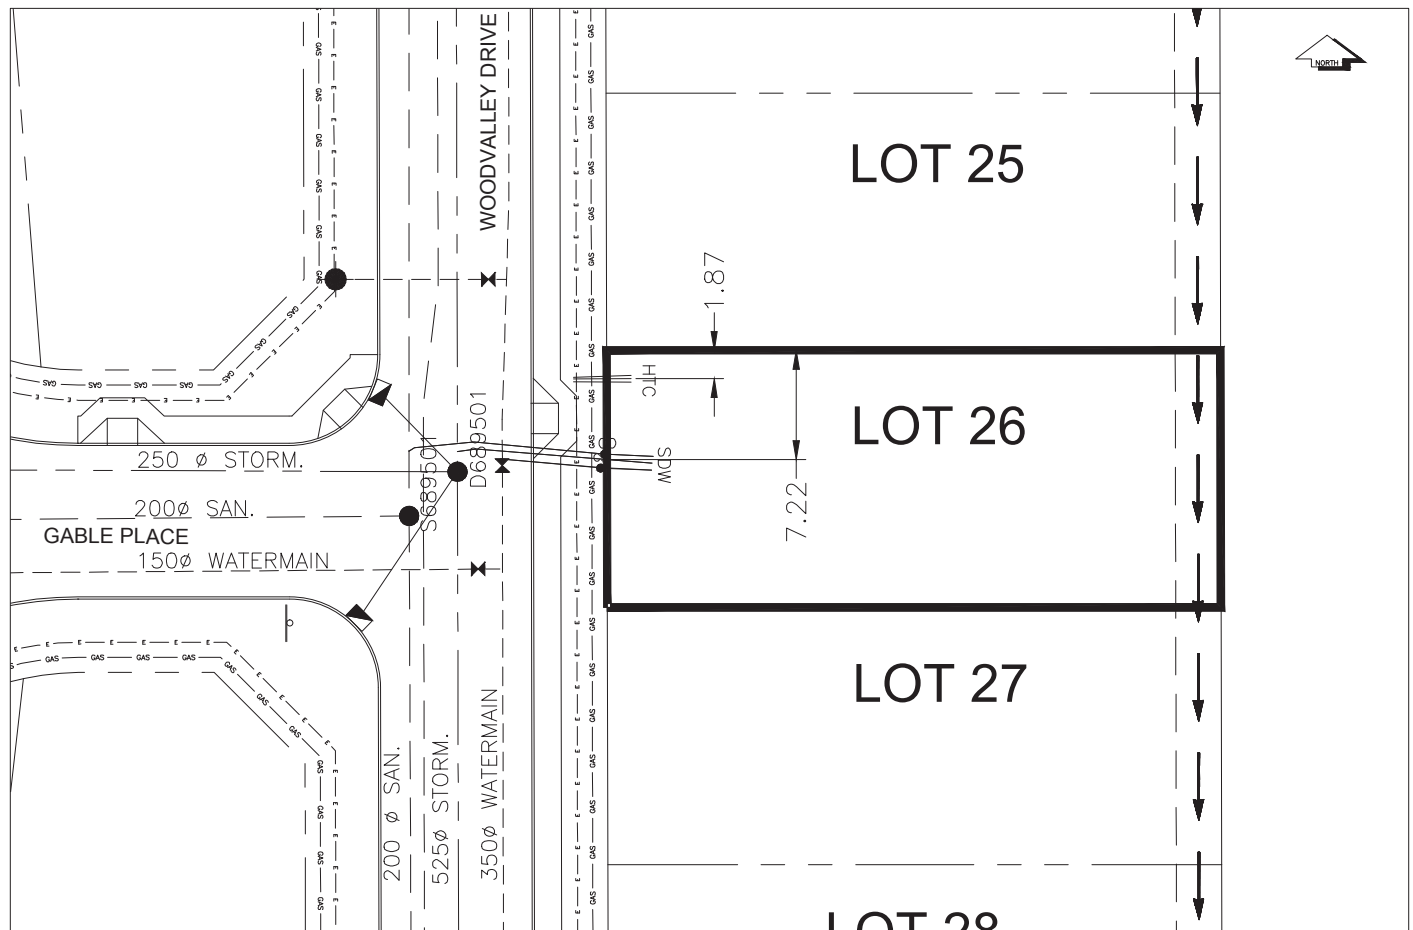

SANITARY, STORM & WATER SERVICE INVERTS	SANITARY	WATER	STORM
1. Distance from San. M.H. ____ - ____ toward San. M.H. <u>689501</u> to lot service connection point is:	56.56m	N/A	N/A
1a.Distance from Stm. M.H. <u>689501</u> toward Stm. M.H. <u>DMH</u> to lot service connection point is:	N/A	N/A	1.34m
2. Main Size at connection point is	200mmØ	350mmØ	525mmØ
3. Invert of main at conn. stub point is	760.18m	761.35m	761.51m
4. Invert at service end is	762.81m	762.70m	762.78m
5. Cover at property line in meters	2.22m	2.56m	2.23m
6. Survey Date:NOV 2007    Book Ref.:1107-09-03    By:FORESIGHT			

**SANITARY HISTORY:**

DATE MAIN INSTALLED: JUN 2008

DATE SERVICES EXTENDED: JUN 2008

INSTALLED BY: WESTERN INDUSTRIAL CONTRACTORS LTD.

**WATER HISTORY:**

DATE MAIN INSTALLED: JUN 2008

DATE SERVICES EXTENDED: JUN 2008

INSTALLED BY: WESTERN INDUSTRIAL CONTRACTORS LTD.

**STORM HISTORY:**

DATE MAIN INSTALLED: JUN 2008

DATE SERVICES EXTENDED: JUN 2008

INSTALLED BY: WESTERN INDUSTRIAL CONTRACTORS LTD.