
## City of Prince George HISTORY SHEET

PID: <b>029-723-50</b>	-507				Scale: 1:500				
Legal: LOT 30					D.L	: 2425	PLAI	N: EPP55596	
Address: 5176 WOO	DVALLEY DF	RIVE							
Sanitary Connection:#	:	SIZE:	100mmØ	MATERIAL:	PVC	INV. @ PL	761.25m	CONNECTED	
Water Connection:#		SIZE:	19mmØ	MATERIAL:	COPPER	INV. @ PL	761.20m	CONNECTED	
Storm Connection:#		SIZE	100mmØ	MATERIAL	PVC	INV. @ PL	761.24m	CONNECTED	
Cash Receipt No's:			WATER		SANITARY		STORM		
CURB FROM PROPERTY LINE 5m					PAV	EMENT WIDTH	10m		
HYDRO	75mm DB2	2			U/G CONNECT	CONNECTION			
TELEPHONE	50mm DB2	2			U/G CONNECT	TION ✓	<i>,</i>		
GAS	42 PROP	/P.E							
Information Sheets:		REF DWGS L&M ENGINEERING LTD. JOB 1107-09-04 DWGS (001-302)							
Comments:	CS CURB STOP WATER SERVICE THYDRO SERVICE GAS STORM SERVICE CABLE SERVICE FELECOMMUNICATIONS ELECT						— GAS ELECTRICAL		

## THE INFORMATION CONTAINED HEREIN IS FOR INTERNAL USE ONLY. NOT TO BE RELIED UPON UNLESS CONFIRMED BY THE SITE INSPECTION AND/OR INVESTIGATION

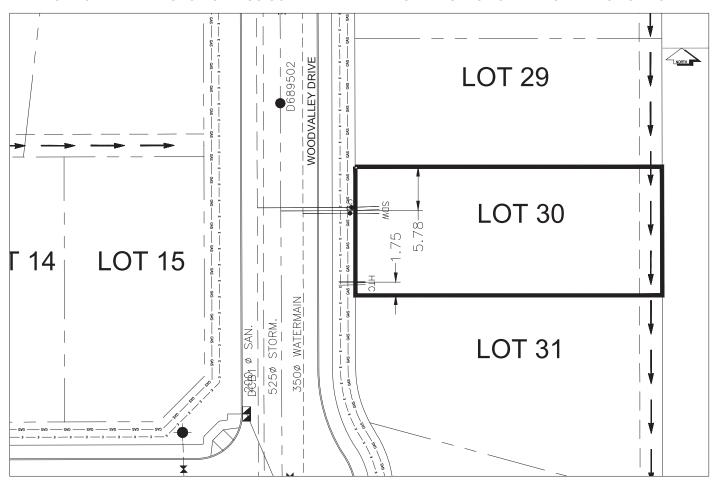

SANITARY, STORM & WATER SERVICE INVERTS	SANITARY	WATER	STORM							
1. Distance from San. M.H. <u>689501</u> toward San. M.H. <u>689503</u> to lot service connection point is:	62.47m	N/A	N/A							
1a.Distance from Stm. M.H. <u>689503</u> toward Stm. M.H. <u>689502</u> to lot service connection point is:	N/A	N/A	37.84m							
2. Main Size at connection point is	200mmØ	350mmØ	525mmØ							
3. Invert of main at conn. stub point is	759.85m	760.27m	760.03m							
4. Invert at service end is	761.49m	761.47m	761.52m							
5. Cover at property line in meters	2.58m	2.72m	2.60m							
6. Survey Date: NOV 2007 Book Ref.:1107-09-03 By: FORESIGHT										
SANITARY HISTORY:										
DATE MAIN INSTALLED: 1995										
DATE SERVICES EXTENDED: SEPT 2007										
INSTALLED BY: WESTERN INDUSTRIAL CONTRACTORS LTD.										
WATER HISTORY:										
DATE MAIN INSTALLED: 1995										
DATE SERVICES EXTENDED: SEPT 2007										
INSTALLED BY: WESTERN INDUSTRIAL CONTRACTORS LTD.										
STORM HISTORY:										
DATE MAIN INSTALLED: 1995										
DATE SERVICES EXTENDED: SEPT 2007										
INSTALLED BY: WESTERN INDUSTRIAL CONTRACTORS LTD.										
2 22 22 22 22 22 22 22 22 22 22 22 22 2										