

# City of Prince George

## HISTORY SHEET

PID: **029-723-515**

Scale: 1:500

Legal: LOT 31

D.L.: 2425

PLAN: EPP55596

Address: **5184 WOODVALLEY DRIVE**

Sanitary Connection:#	SIZE: 100mmØ	MATERIAL: PVC	INV. @ PL	760.92m	CONNECTED
-----------------------	--------------	---------------	-----------	---------	-----------

Water Connection:#	SIZE: 19mmØ	MATERIAL: COPPER	INV. @ PL	760.87m	CONNECTED
--------------------	-------------	------------------	-----------	---------	-----------

Storm Connection:#	SIZE: 100mmØ	MATERIAL: PVC	INV. @ PL	760.90m	CONNECTED
--------------------	--------------	---------------	-----------	---------	-----------

Cash Receipt No's:	WATER	SANITARY	STORM
--------------------	-------	----------	-------

CURB FROM PROPERTY LINE	5m	PAVEMENT WIDTH	10m
-------------------------	----	----------------	-----

HYDRO	75mm DB2	U/G CONNECTION	✓
-------	----------	----------------	---


TELEPHONE	50mm DB2	U/G CONNECTION	✓
-----------	----------	----------------	---

GAS	42 PROP /P.E		
-----	--------------	--	--

Information Sheets: REF DWGS L&M ENGINEERING LTD. JOB 1107-09-04 DWGS (001-302)

Comments:	CS CURB STOP	SDW WATER SERVICE	TCH HYDRO SERVICE	— GAS — GAS
	CO CLEAN OUT	SDW STORM SERVICE	TCH CABLE SERVICE	— f — f — ELECTRICAL
		SDW SANITARY SERVICE	TCH TELECOMMUNICATIONS	

THE INFORMATION CONTAINED HEREIN IS FOR INTERNAL USE ONLY.  
NOT TO BE RELIED UPON UNLESS CONFIRMED BY THE SITE INSPECTION AND/OR INVESTIGATION

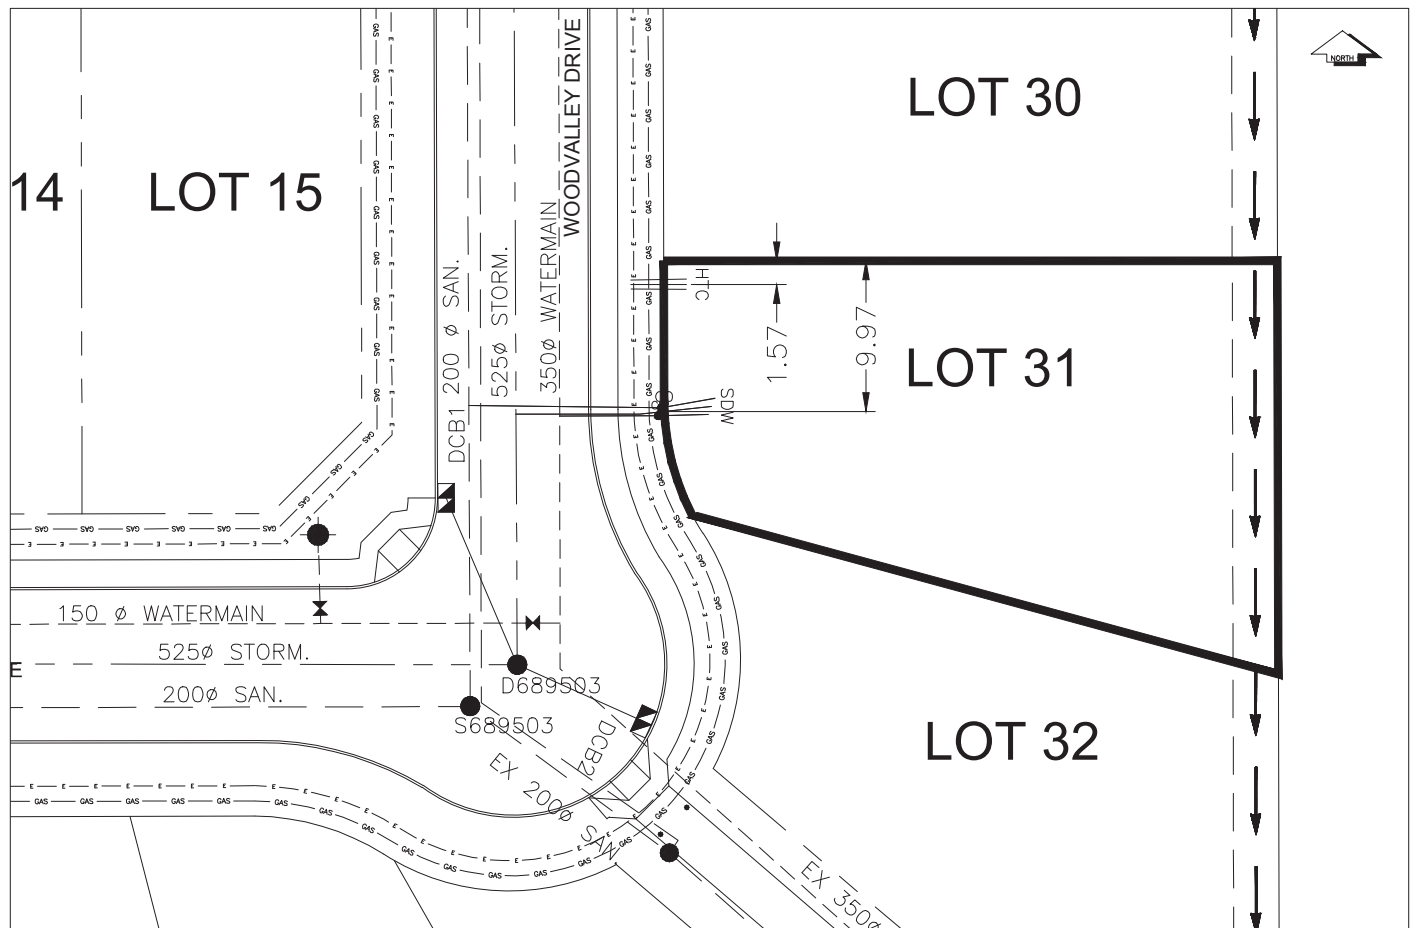

SANITARY, STORM & WATER SERVICE INVERTS	SANITARY	WATER	STORM
1. Distance from San. M.H. <u>689501</u> toward San. M.H. <u>689503</u> to lot service connection point is:	83.62m	N/A	N/A
1a.Distance from Stm. M.H. <u>689503</u> toward Stm. M.H. <u>689501</u> to lot service connection point is:	N/A	N/A	16.57m
2. Main Size at connection point is	200mmØ	350mmØ	525mmØ
3. Invert of main at conn. stub point is	759.76m	760.27m	760.13m
4. Invert at service end is	761.01m	760.97m	761.01m
5. Cover at property line in meters	2.59m	2.71m	2.61m
6. Survey Date:NOV 2007    Book Ref.:1107-09-03    By:FORESIGHT			

**SANITARY HISTORY:**

DATE MAIN INSTALLED: 1995

DATE SERVICES EXTENDED: SEPT 2007

INSTALLED BY: WESTERN INDUSTRIAL CONTRACTORS LTD.

---

---

**WATER HISTORY:**

DATE MAIN INSTALLED: 1995

DATE SERVICES EXTENDED: SEPT 2007

INSTALLED BY: WESTERN INDUSTRIAL CONTRACTORS LTD.

---

---

**STORM HISTORY:**

DATE MAIN INSTALLED: 1995

DATE SERVICES EXTENDED: SEPT 2007

INSTALLED BY: WESTERN INDUSTRIAL CONTRACTORS LTD.

---

---

