
City of Prince George HISTORY SHEET

PID: 0	29-723-523					Scal	e: 1:500		
Legal: Lo	OT 32					D.L.:	2425	PLAN:	EPP55596
Address: 5	192 WOOD	VALLEY DRIV	Æ						
Sanitary Co	onnection:#		SIZE:	100mmØ	MATERIAL:	PVC	INV. @ PL	760.98m	CONNECTED
Water Conr	nection:#		SIZE:	19mmØ	MATERIAL:	COPPER	INV. @ PL	760.87m	CONNECTED
Storm Conr	nection:#		SIZE	100mmØ	MATERIAL	PVC	INV. @ PL	760.96m	CONNECTED
Cash Recei	ipt No's:			WATER		SANITARY		STORM	
CURB FROM PROPERTY LINE 5r			5m				PAV	EMENT WIDTH	10m
HYDRO		75mm DB2				U/G CONNECTION	ON ✓	<i>,</i>	
TELEPHON	NE	50mm DB2				U/G CONNECTION	ON <	/	
GAS		42 PROP /P.	E						
Information	Sheets:	REF DWGS L&M ENGINEERING LTD. JOB 1107-09-04 DWGS (001-302)							
Comments:	:	CS CURB STOP STORM SERVICE SHYDRO SERVICE CABLE SERVICE CABLE SERVICE SANITARY SERVICE TELECOMMUNICATIONS						CE — GAS— CE IICATIONS — E — E	— GAS— ELECTRICAL

THE INFORMATION CONTAINED HEREIN IS FOR INTERNAL USE ONLY. NOT TO BE RELIED UPON UNLESS CONFIRMED BY THE SITE INSPECTION AND/OR INVESTIGATION

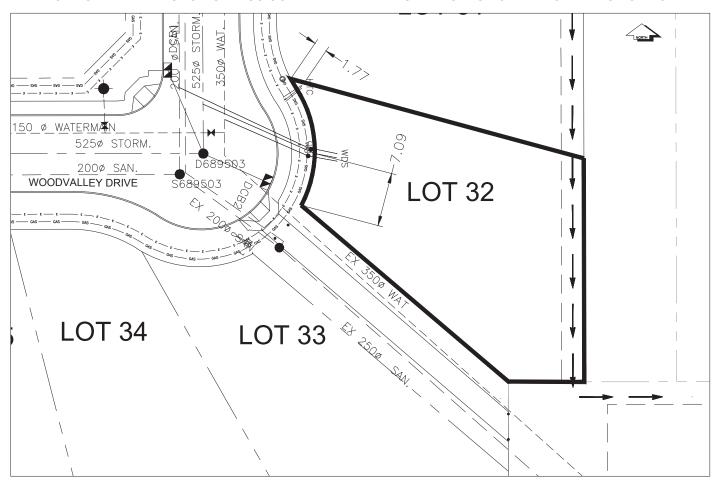

SANITARY, STORM & WATER SERVICE INVERTS	SANITARY	WATER	STORM
1. Distance from San. M.H. <u>689501</u> toward San. M.H. <u>689503</u> to lot service connection point is:	92.02m	N/A	N/A
1a.Distance from Stm. M.H. <u>689503</u> toward Stm. M.H. <u>689501</u> to lot service connection point is:	N/A	N/A	6.53m
2. Main Size at connection point is	200mmØ	350mmØ	525mmØ
3. Invert of main at conn. stub point is	759.71m	761.47m	760.21m
4. Invert at service end is	761.16m	761.12m	761.20m
5. Cover at property line in meters	2.38m	2.56m	2.40m
6. Survey Date: NOV 2007 Book Ref.:1107-09-03 By:FORESIGHT			
SANITARY HISTORY:			
DATE MAIN INSTALLED: 1995			
DATE SERVICES EXTENDED: SEPT 2007			
INSTALLED BY: WESTERN INDUSTRIAL CONTRACTORS LTD.			
WATER HISTORY			
WATER HISTORY:			
DATE MAIN INSTALLED: 1995			
DATE SERVICES EXTENDED: SEPT 2007			
INSTALLED BY: WESTERN INDUSTRIAL CONTRACTORS LTD.			
STORM HISTORY:			
DATE MAIN INSTALLED: 1995			
DATE SERVICES EXTENDED: SEPT 2007			
INSTALLED BY: WESTERN INDUSTRIAL CONTRACTORS LTD.			