

# City of Prince George

## HISTORY SHEET

PID: **029-723-621**

Scale: 1:500

Legal: LOT 42

D.L.: 2425

PLAN: EPP55596

Address: **5425 WOODVALLEY DRIVE**

|                       |              |               |           |         |           |
|-----------------------|--------------|---------------|-----------|---------|-----------|
| Sanitary Connection:# | SIZE: 100mmØ | MATERIAL: PVC | INV. @ PL | 763.52m | CONNECTED |
|-----------------------|--------------|---------------|-----------|---------|-----------|

|                    |             |                  |           |         |           |
|--------------------|-------------|------------------|-----------|---------|-----------|
| Water Connection:# | SIZE: 19mmØ | MATERIAL: COPPER | INV. @ PL | 763.39m | CONNECTED |
|--------------------|-------------|------------------|-----------|---------|-----------|

|                    |              |               |           |         |           |
|--------------------|--------------|---------------|-----------|---------|-----------|
| Storm Connection:# | SIZE: 100mmØ | MATERIAL: PVC | INV. @ PL | 763.50m | CONNECTED |
|--------------------|--------------|---------------|-----------|---------|-----------|

|                    |       |          |       |
|--------------------|-------|----------|-------|
| Cash Receipt No's: | WATER | SANITARY | STORM |
|--------------------|-------|----------|-------|

|                         |    |                |     |
|-------------------------|----|----------------|-----|
| CURB FROM PROPERTY LINE | 5m | PAVEMENT WIDTH | 10m |
|-------------------------|----|----------------|-----|

|       |          |                |   |
|-------|----------|----------------|---|
| HYDRO | 75mm DB2 | U/G CONNECTION | ✓ |
|-------|----------|----------------|---|


|           |          |                |   |
|-----------|----------|----------------|---|
| TELEPHONE | 50mm DB2 | U/G CONNECTION | ✓ |
|-----------|----------|----------------|---|

|     |              |  |  |
|-----|--------------|--|--|
| GAS | 42 PROP /P.E |  |  |
|-----|--------------|--|--|

Information Sheets: REF DWGS L&M ENGINEERING LTD. JOB 1107-09-04 DWGS (001-302)

Comments: CS CURB STOP CO CLEAN OUT WDS WATER SERVICE SOW STORM SERVICE SOW SANITARY SERVICE H HYDRO SERVICE C CABLE SERVICE T TELECOMMUNICATIONS GAS GAS ELECTRICAL

THE INFORMATION CONTAINED HEREIN IS FOR INTERNAL USE ONLY.  
NOT TO BE RELIED UPON UNLESS CONFIRMED BY THE SITE INSPECTION AND/OR INVESTIGATION

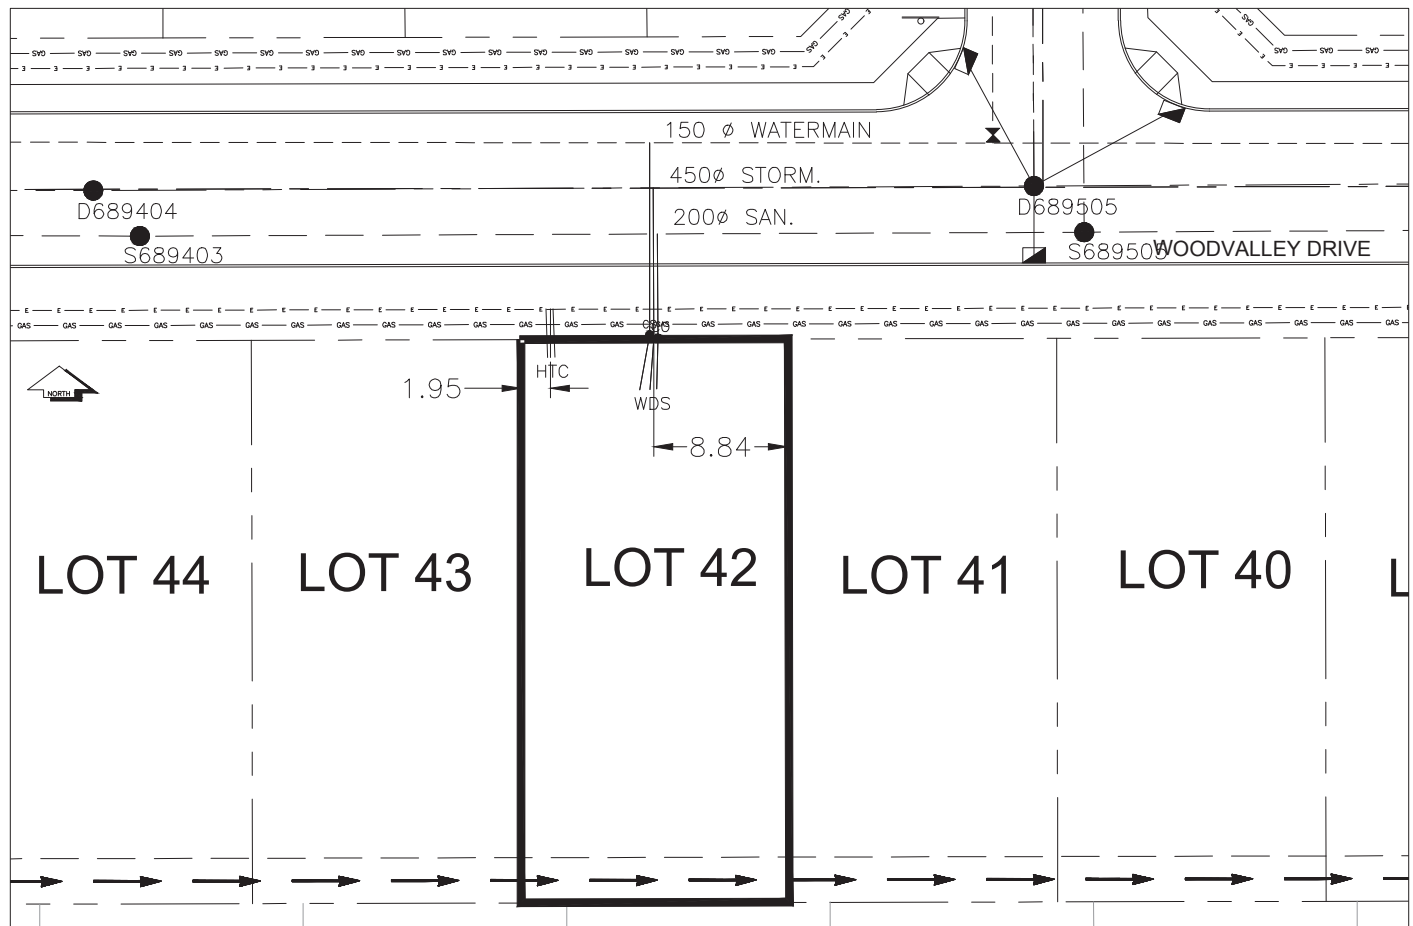

| SANITARY, STORM & WATER SERVICE INVERTS   | SANITARY | WATER   | STORM   |
|---|----------|---------|---------|
| 1. Distance from San. M.H. <u>689403</u> toward San. M.H. <u>689505</u> to lot service connection point is: | 34.10m   | N/A     | N/A     |
| 1a.Distance from Stm. M.H. <u>689404</u> toward Stm. M.H. <u>689505</u> to lot service connection point is: | N/A      | N/A     | 37.02m  |
| 2. Main Size at connection point is   | 200mmØ   | 150mmØ  | 450mmØ  |
| 3. Invert of main at conn. stub point is  | 761.89m  | 762.73m | 760.99m |
| 4. Invert at service end is   | 763.63m  | 763.80m | 763.66m |
| 5. Cover at property line in meters   | 2.52m    | 2.73m   | 2.54m   |
| 6. Survey Date:NOV 2007    Book Ref.:1107-09-03    By:FORESIGHT   |          |         |         |
|   |          |         |         |
|   |          |         |         |
### SANITARY HISTORY:

DATE MAIN INSTALLED: 1995

DATE SERVICES EXTENDED: SEPT 2007

INSTALLED BY: WESTERN INDUSTRIAL CONTRACTORS LTD.

### WATER HISTORY:

DATE MAIN INSTALLED: 1995

DATE SERVICES EXTENDED: SEPT 2007

INSTALLED BY: WESTERN INDUSTRIAL CONTRACTORS LTD.

### STORM HISTORY:

DATE MAIN INSTALLED: 1995

DATE SERVICES EXTENDED: SEPT 2007

INSTALLED BY: WESTERN INDUSTRIAL CONTRACTORS LTD.