
## City of Prince George HISTORY SHEET

PID: <b>029-723</b> -	-710				Scal	e: 1:500			
Legal: LOT 48					D.L.:	2425	PLAN	: EPP55596	
Address: <b>5250 W</b> C	OODSTOCK CO	OURT							
Sanitary Connection	n:#	SIZE:	100mmØ	MATERIAL:	PVC	INV. @ PL	761.92m	CONNECTED	
Water Connection:#	<del>‡</del>	SIZE:	19mmØ	MATERIAL:	COPPER	INV. @ PL	761.74m	CONNECTED	
Storm Connection:#	<b>#</b>	SIZE	100mmØ	MATERIAL	PVC	INV. @ PL	761.92m	CONNECTED	
Cash Receipt No's:			WATER		SANITARY		STORM		
CURB FROM PROPERTY LINE 5m					PAV	EMENT WIDTH	10m		
HYDRO	75mm DB	32			U/G CONNECTION				
TELEPHONE	50mm DB	32			U/G CONNECTION	ON ✓	/		
GAS	42 PROP	42 PROP /P.E							
Information Sheets:	:	REF DWGS L&M ENGINEERING LTD. JOB 1107-09-04 DWGS (001-302)							
Comments:	CS <sub>O</sub>	CS CURB STOP						— GAS — ELECTRICAL	

## THE INFORMATION CONTAINED HEREIN IS FOR INTERNAL USE ONLY. NOT TO BE RELIED UPON UNLESS CONFIRMED BY THE SITE INSPECTION AND/OR INVESTIGATION

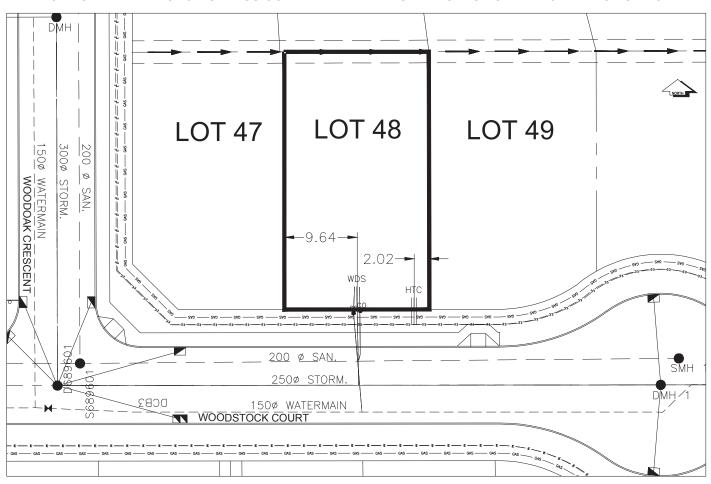

SANITARY, STORM & WATER SERVICE INVERTS	SANITARY	WATER	STORM							
1. Distance from San. M.H. SMH1 toward San. M.H. 689601 to lot service connection point is:	42.45m	N/A	N/A							
1a.Distance from Stm. M.H. DMH1 toward Stm. M.H. 689601 to lot service connection point is:	N/A	N/A	39.98m							
2. Main Size at connection point is	200mmØ	150mmØ	250mmØ							
3. Invert of main at conn. stub point is	760.86m	760.78m	761.48m							
4. Invert at service end is	762.01m	761.93m	761.97m							
5. Cover at property line in meters	2.22m	2.48m	2.22m							
6. Survey Date: JULY 2008 Book Ref.:1107-09-03 By:FORESIGHT										
SANITARY HISTORY:										
DATE MAIN INSTALLED: JULY 2008										
DATE SERVICES EXTENDED: JULY 2008  INSTALLED BY: WESTERN INDUSTRIAL CONTRACTORS LTD.										
WESTERN INDUSTRIAL CONTINUIONS ETD.										
WATER HISTORY:										
DATE MAIN INSTALLED: JULY 2008										
DATE SERVICES EXTENDED: JULY 2008										
INSTALLED BY: WESTERN INDUSTRIAL CONTRACTORS LTD.										
STORM HISTORY:										
DATE MAIN INSTALLED: JULY 2008										
DATE SERVICES EXTENDED: JULY 2008										
INSTALLED BY: WESTERN INDUSTRIAL CONTRACTORS LTD.										