

# City of Prince George

## HISTORY SHEET

PID: 029-734-789

Scale: 1:500

Legal: LOT 6

D.L.: 1433

PLAN: EPP55599

Address: 2969 ELLINGTON AVE

Sanitary Connection:#	SIZE: 100mmØ	MATERIAL: PVC	INV. 648.68m	CONNECTED
-----------------------	--------------	---------------	--------------	-----------

Water Connection:#	SIZE: 19mmØ	MATERIAL: COPPER	INV. 648.66m	CONNECTED
--------------------	-------------	------------------	--------------	-----------

Storm Connection:#	SIZE: 100mmØ	MATERIAL: PVC	INV. 648.66m	CONNECTED
--------------------	--------------	---------------	--------------	-----------

Cash Receipt No's:	WATER	SANITARY	STORM
--------------------	-------	----------	-------

CURB FROM PROPERTY LINE	5m	PAVEMENT WIDTH	10m
-------------------------	----	----------------	-----

HYDRO	75mm DB2	U/G CONNECTION	✓
-------	----------	----------------	---


TELEPHONE	50mm DB2	U/G CONNECTION	✓
-----------	----------	----------------	---

GAS	42 PROP/P.E.
-----	--------------

Information Sheets: REF. DWGS. L&M ENGINEERING LTD. JOB 1432-03

Comments: CS CURB STOP WATER SERVICE HYDRO SERVICE GAS GAS  
CO CLEAN OUT STORM SERVICE CABLE SERVICE E ELECTRICAL  
 SANITARY SERVICE TELECOMMUNICATIONS

**THE INFORMATION CONTAINED HEREIN IS FOR INTERNAL USE ONLY.  
 NOT TO BE RELIED UPON UNLESS CONFIRMED BY THE SITE INSPECTION AND/OR INVESTIGATION**

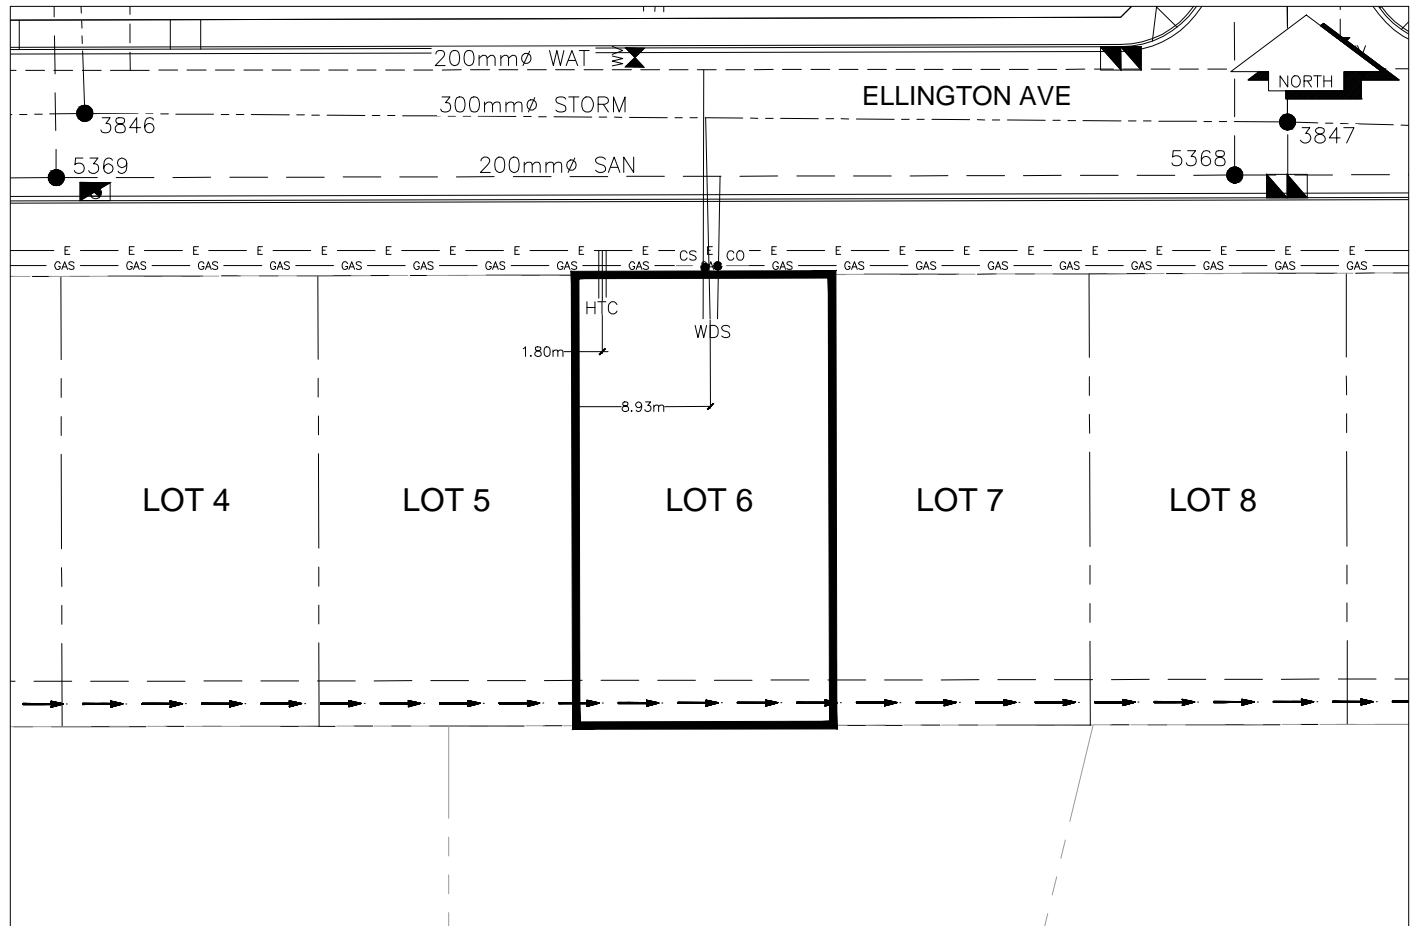

SANITARY, STORM & WATER SERVICE INVERTS	SANITARY	WATER	STORM
1. Distance from San. M.H. <u>5368</u> toward San. M.H. <u>5369</u> to lot service connection point is:	33.96m	N/A	N/A
1a.Distance from Stm. M.H. <u>3847</u> toward Stm. M.H. <u>3846</u> to lot service connection point is:	N/A	N/A	38.54m
2. Main Size at connection point is	200mmØ	200mmØ	250mmØ
3. Invert of main at conn. stub point is	647.63m	648.08m	647.34m
4. Invert at service end is	648.76m	648.78m	648.86m
5. Cover at property line in meters	2.68m	2.82m	2.72m
6. Survey Date:JUNE 2015 Book Ref.:1432-03 By:L&M ENGINEERING LTD.			

### SANITARY HISTORY:

DATE INSTALLED: JUNE 2015

INSTALLED BY: JOE ROBERTS CONSTRUCTION & CONSULTING SERVICE LTD.

### WATER HISTORY:

DATE INSTALLED: JUNE 2015

INSTALLED BY: JOE ROBERTS CONSTRUCTION & CONSULTING SERVICE LTD.

### STORM HISTORY:

DATE INSTALLED: JUNE 2015

INSTALLED BY: JOE ROBERTS CONSTRUCTION & CONSULTING SERVICE LTD.