

City of Prince George

HISTORY SHEET

PID: 029-734-797

Scale: 1:500

Legal: LOT 7

D.L.: 1433

PLAN: EPP55599

Address: 2963 ELLINGTON AVE

Sanitary Connection:#	SIZE: 100mmØ	MATERIAL: PVC	INV. 647.96m	CONNECTED
-----------------------	--------------	---------------	--------------	-----------

Water Connection:#	SIZE: 19mmØ	MATERIAL: COPPER	INV. 648.00m	CONNECTED
--------------------	-------------	------------------	--------------	-----------

Storm Connection:#	SIZE: 100mmØ	MATERIAL: PVC	INV. 647.97m	CONNECTED
--------------------	--------------	---------------	--------------	-----------

Cash Receipt No's:	WATER	SANITARY	STORM
--------------------	-------	----------	-------

CURB FROM PROPERTY LINE 5m	PAVEMENT WIDTH 10m
----------------------------	--------------------

HYDRO	75mm DB2	U/G CONNECTION	✓
-------	----------	----------------	---


TELEPHONE	50mm DB2	U/G CONNECTION	✓
-----------	----------	----------------	---

GAS	42 PROP/P.E.
-----	--------------

Information Sheets: REF. DWGS. L&M ENGINEERING LTD. JOB 1432-03

Comments: CS CURB STOP CO CLEAN OUT WDS WATER SERVICE SOW STORM SERVICE SANITARY SERVICE HTC HYDRO SERVICE CABLE SERVICE TELECOMMUNICATIONS GAS GAS E ELECTRICAL

**THE INFORMATION CONTAINED HEREIN IS FOR INTERNAL USE ONLY.
NOT TO BE RELIED UPON UNLESS CONFIRMED BY THE SITE INSPECTION AND/OR INVESTIGATION**

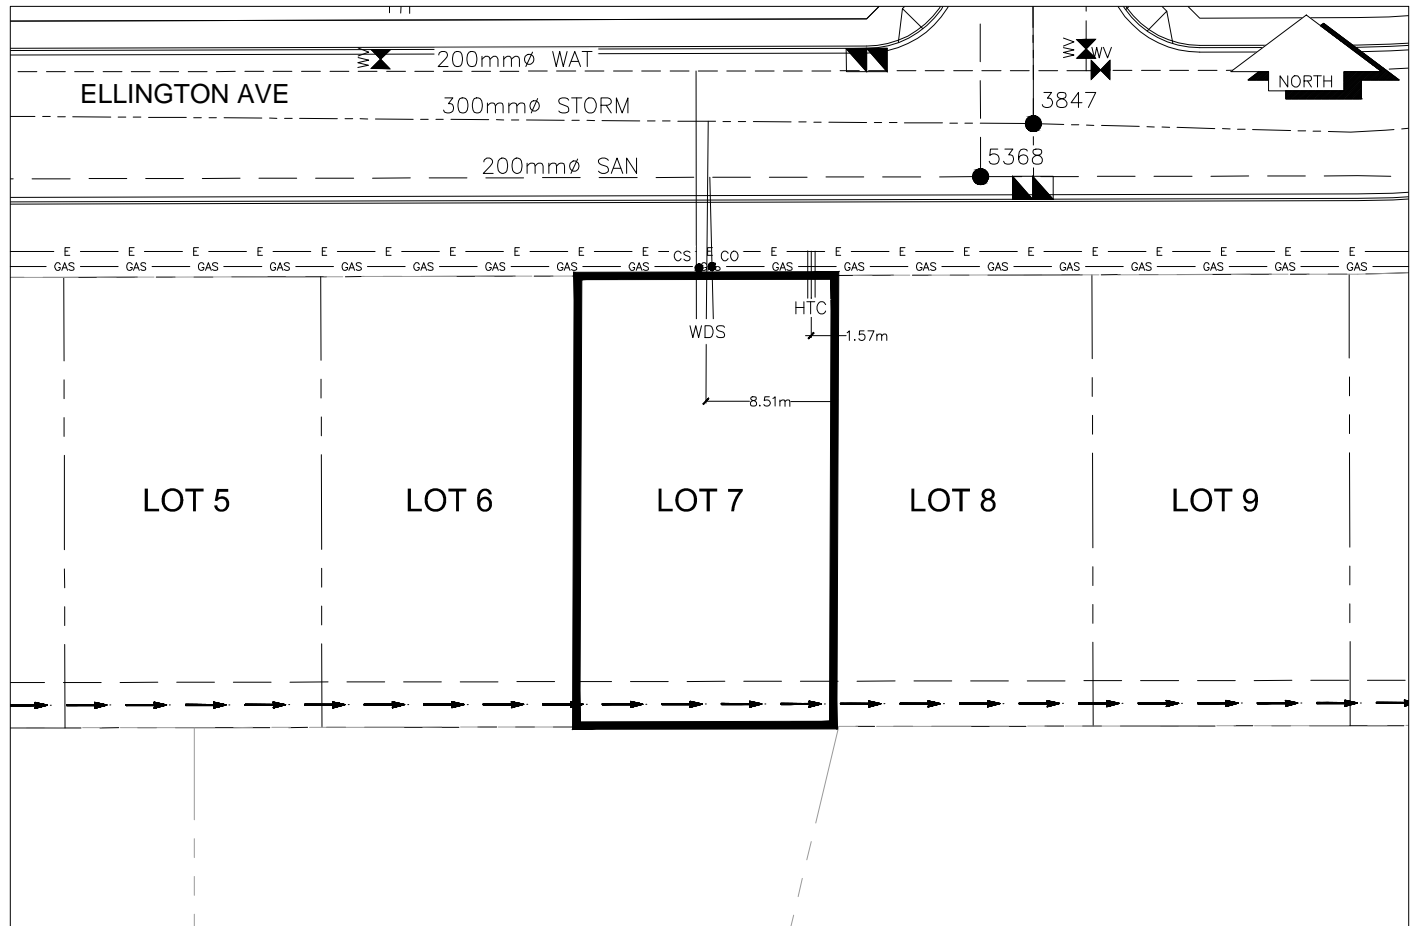

SANITARY, STORM & WATER SERVICE INVERTS	SANITARY	WATER	STORM
1. Distance from San. M.H. <u>5368</u> toward San. M.H. <u>5269</u> to lot service connection point is:	17.99m	N/A	N/A
1a.Distance from Stm. M.H. <u>3847</u> toward Stm. M.H. <u>3846</u> to lot service connection point is:	N/A	N/A	21.30m
2. Main Size at connection point is	200mmØ	200mmØ	300mmØ
3. Invert of main at conn. stub point is	646.89m	647.37m	646.57m
4. Invert at service end is	648.02m	648.06m	648.06m
5. Cover at property line in meters	2.60m	2.68m	2.61m
6. Survey Date:JUNE 2015 Book Ref.:1432-03 By:L&M ENGINEERING LTD.			

SANITARY HISTORY:

DATE INSTALLED: JUNE 2015

INSTALLED BY: JOE ROBERTS CONSTRUCTION & CONSULTING SERVICE LTD.

WATER HISTORY:

DATE INSTALLED: JUNE 2015

INSTALLED BY: JOE ROBERTS CONSTRUCTION & CONSULTING SERVICE LTD.

STORM HISTORY:

DATE INSTALLED: JUNE 2015

INSTALLED BY: JOE ROBERTS CONSTRUCTION & CONSULTING SERVICE LTD.