
## City of Prince George HISTORY SHEET

PID:	029-734-819					Scale	e: 1:500		
Legal:	LOT 9					D.L.:	1433		PLAN: EPP55599
Address	: 2949 ELLING1	ON AVE							
Sanitary	Connection:#		SIZE:	100mmØ	MATERIAL:	PVC	INV.	646.29m	CONNECTED
Water C	onnection:#		SIZE:	19mmØ	MATERIAL:	COPPER	INV.	646.31m	CONNECTED
Storm C	onnection:#		SIZE	100mmØ	MATERIAL	PVC	INV.	646.26m	CONNECTED
Cash Re	eceipt No's:			WATER		SANITARY			STORM
CURB FROM PROPERTY LINE 5m					PAVEMENT WIDTH 10m				
HYDRO		75mm DB2				U/G CONNECTION	ON		
TELEPH	IONE	50mm DB2				U/G CONNECTION	ON	/	
GAS		42 PROP/P.E							
Informat	nformation Sheets: REF. DWGS. L&M ENGINEERING LTD. JOB 1432-03								
Comme	nts:	CS CUR	B STOP AN OUT		WATER SERVICE STORM SERVICE SANITARY SERV	ICE =	HYDRO CABLE TELEC	SERVICE SERVICE OMMUNICAST	— GAS — GAS IONS — E — ELECTRICAL

## THE INFORMATION CONTAINED HEREIN IS FOR INTERNAL USE ONLY. NOT TO BE RELIED UPON UNLESS CONFIRMED BY THE SITE INSPECTION AND/OR INVESTIGATION

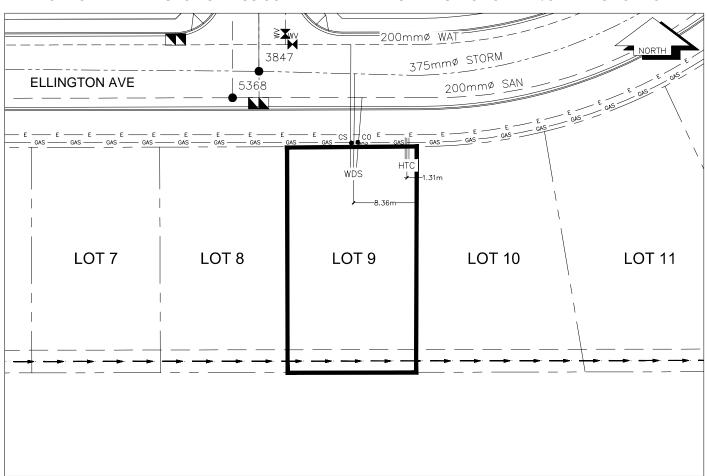

SANITARY, STORM & WATER SERVICE INVERTS	SANITARY	WATER	STORM
1. Distance from San. M.H. <u>5368</u> toward San. M.H. <u>5367</u> to lot service connection point is:	17.16m	N/A	N/A
1a.Distance from Stm. M.H. 3847 toward Stm. M.H. 3800 to lot service connection point is:	N/A	N/A	12.79m
2. Main Size at connection point is	200mmØ	200mmØ	375mmØ
3. Invert of main at conn. stub point is	645.01m	645.75m	644.76m
4. Invert at service end is	646.40m	646.41m	646.40m
5. Cover at property line in meters	2.32m	2.45m	2.38m
6. Survey Date: JUNE 2015 Book Ref.:1432-03 By:L&M ENGINEERING LTD.			
SANITARY HISTORY:			
DATE INSTALLED: JUNE 2015			
INSTALLED BY: JOE ROBERTS CONSTRUCTION & CONSULTING SERVICE LTD.			
THE PROPERTY OF THE PROPERTY O			
WATER HISTORY:			
DATE INSTALLED: JUNE 2015			
INSTALLED BY: JOE ROBERTS CONSTRUCTION & CONSULTING SERVICE LTD.			
STORM HISTORY:			
DATE INSTALLED: JUNE 2015			
INSTALLED BY: JOE ROBERTS CONSTRUCTION & CONSULTING SERVICE LTD.			