

City of Prince George

HISTORY SHEET

PID: 029-734-827

Scale: 1:500

Legal: LOT 10

D.L.: 1433

PLAN: EPP55599

Address: 2943 ELLINGTON AVE

| | | | | |
|-----------------------|--------------|---------------|--------------|-----------|
| Sanitary Connection:# | SIZE: 100mmØ | MATERIAL: PVC | INV. 645.29m | CONNECTED |
|-----------------------|--------------|---------------|--------------|-----------|

| | | | | |
|--------------------|-------------|------------------|--------------|-----------|
| Water Connection:# | SIZE: 19mmØ | MATERIAL: COPPER | INV. 645.31m | CONNECTED |
|--------------------|-------------|------------------|--------------|-----------|

| | | | | |
|--------------------|-------------|--------------|--------------|-----------|
| Storm Connection:# | SIZE 100mmØ | MATERIAL PVC | INV. 645.29m | CONNECTED |
|--------------------|-------------|--------------|--------------|-----------|

| | | | |
|--------------------|-------|----------|-------|
| Cash Receipt No's: | WATER | SANITARY | STORM |
|--------------------|-------|----------|-------|

| | | | |
|-------------------------|----|----------------|-----|
| CURB FROM PROPERTY LINE | 5m | PAVEMENT WIDTH | 10m |
|-------------------------|----|----------------|-----|

| | | | |
|-------|----------|----------------|---|
| HYDRO | 75mm DB2 | U/G CONNECTION | ✓ |
|-------|----------|----------------|---|


| | | | |
|-----------|----------|----------------|---|
| TELEPHONE | 50mm DB2 | U/G CONNECTION | ✓ |
|-----------|----------|----------------|---|

| | |
|-----|--------------|
| GAS | 42 PROP/P.E. |
|-----|--------------|

Information Sheets: REF. DWGS. L&M ENGINEERING LTD. JOB 1432-03

| | | | | |
|-----------|------------------------------|---|--|-------------------------------|
| Comments: | CS CURB STOP CO CLEAN OUT | SOW WATER SERVICE STORM SERVICE SANITARY SERVICE | HYDRO SERVICE CABLE SERVICE TELECOMMUNICATIONS | GAS E GAS ELECTRICAL |
|-----------|------------------------------|---|--|-------------------------------|

**THE INFORMATION CONTAINED HEREIN IS FOR INTERNAL USE ONLY.
NOT TO BE RELIED UPON UNLESS CONFIRMED BY THE SITE INSPECTION AND/OR INVESTIGATION**

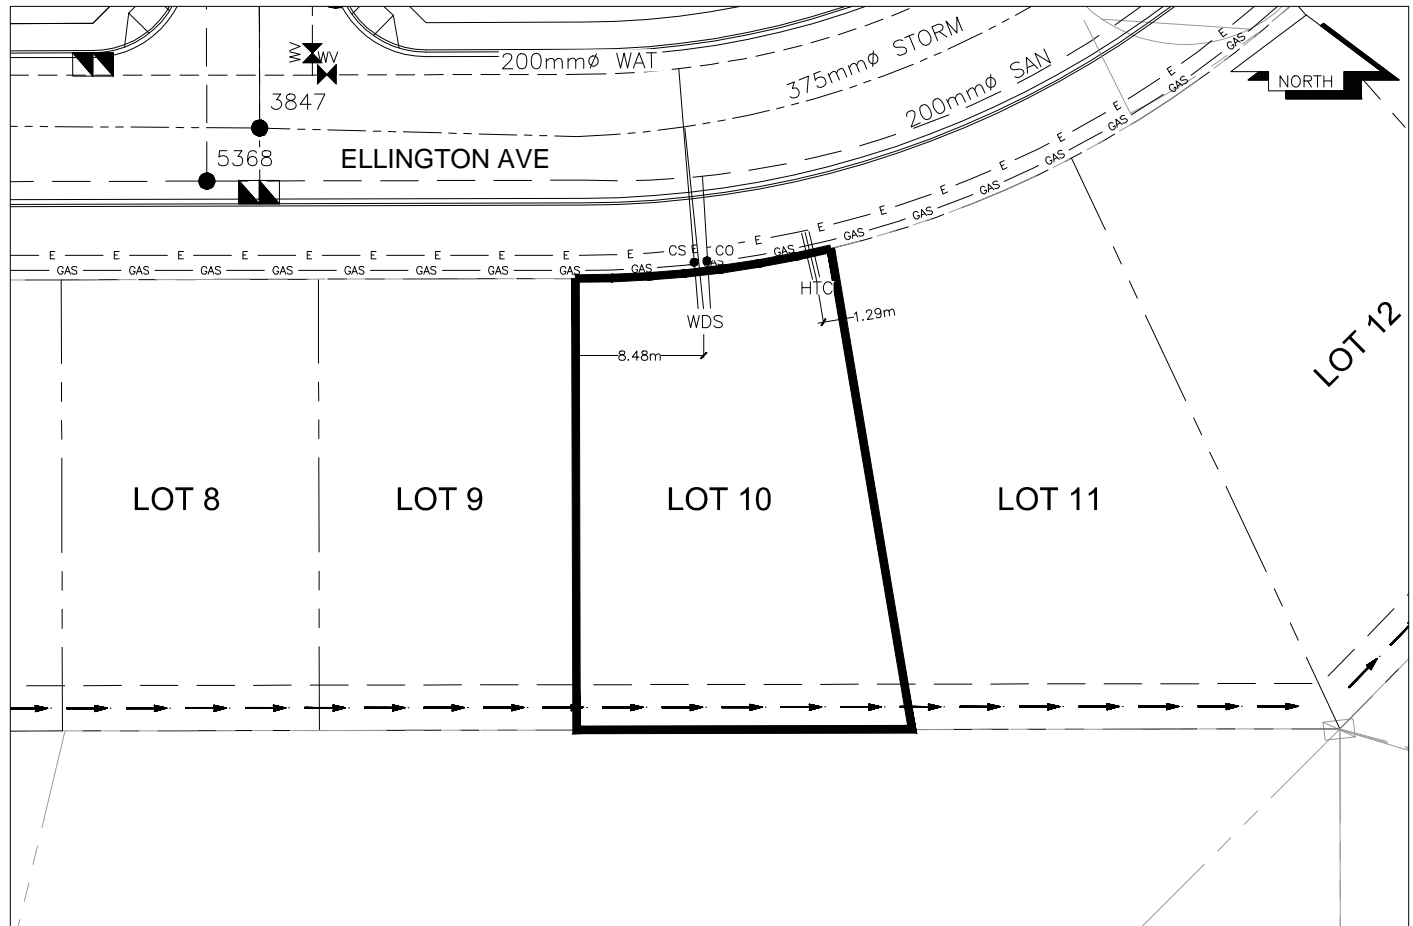

| SANITARY, STORM & WATER SERVICE INVERTS | SANITARY | WATER | STORM |
|---|----------|---------|---------|
| 1. Distance from San. M.H. <u>5368</u> toward San. M.H. <u>5367</u> to lot service connection point is: | 32.69m | N/A | N/A |
| 1a.Distance from Stm. M.H. <u>3847</u> toward Stm. M.H. <u>3800</u> to lot service connection point is: | N/A | N/A | 29.15m |
| 2. Main Size at connection point is | 200mmØ | 200mmØ | 375mmØ |
| 3. Invert of main at conn. stub point is | 644.00m | 644.72m | 643.76m |
| 4. Invert at service end is | 645.36m | 645.32m | 645.33m |
| 5. Cover at property line in meters | 2.35m | 2.46m | 2.36m |
| 6. Survey Date:JUNE 2015 Book Ref.:1432-03 By:L&M ENGINEERING LTD. | | | |
| | | | |
| | | | |
SANITARY HISTORY:

DATE INSTALLED: JUNE 2015

INSTALLED BY: JOE ROBERTS CONSTRUCTION & CONSULTING SERVICE LTD.

WATER HISTORY:

DATE INSTALLED: JUNE 2015

INSTALLED BY: JOE ROBERTS CONSTRUCTION & CONSULTING SERVICE LTD.

STORM HISTORY:

DATE INSTALLED: JUNE 2015

INSTALLED BY: JOE ROBERTS CONSTRUCTION & CONSULTING SERVICE LTD.