
## City of Prince George HISTORY SHEET

PID:	029-734-851					Scale	e: 1:500		
Legal:	LOT 13					D.L.:	1433		PLAN: EPP55599
Address	: 2921 ELLING	STON AVE							
Sanitary	Connection:#		SIZE:	100mmØ	MATERIAL:	PVC	INV.	642.39m	CONNECTED
Water C	onnection:#		SIZE:	19mmØ	MATERIAL:	COPPER	INV.	642.39m	CONNECTED
Storm C	onnection:#		SIZE	100mmØ	MATERIAL	PVC	INV.	642.39m	CONNECTED
Cash Re	eceipt No's:			WATER		SANITARY			STORM
CURB F	ROM PROPER	Y LINE 5m						PAVEMEN	T WIDTH 10m
HYDRO		75mm DB2				U/G CONNECTION	ON		
TELEPH	IONE	50mm DB2				U/G CONNECTION	ON	/	
GAS		42 PROP/P.E							
Informat	formation Sheets: REF. DWGS. L&M ENGINEERING LTD. JOB 1432-03								
Comme	nts:	CS CURB STOP WATER SERVICE THYDRO SERVICE GAS  CO CLEAN OUT GAS STORM SERVICE TELECOMMUNICASTIONS E ELECTRICAL							

## THE INFORMATION CONTAINED HEREIN IS FOR INTERNAL USE ONLY. NOT TO BE RELIED UPON UNLESS CONFIRMED BY THE SITE INSPECTION AND/OR INVESTIGATION

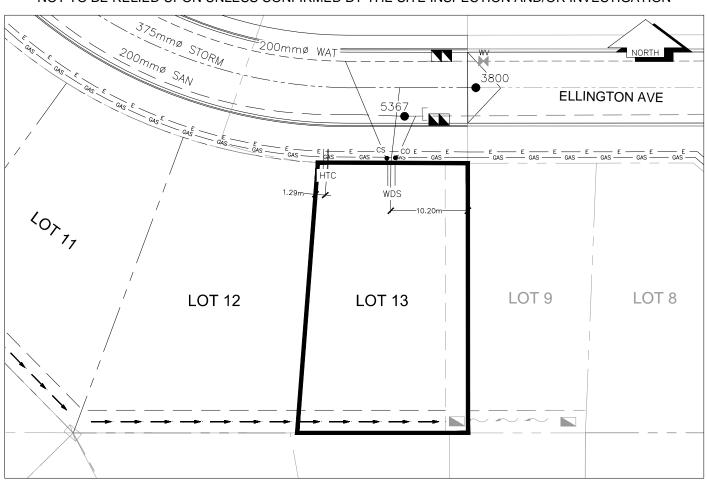

SANITARY, STORM & WATER SERVICE INVERTS	SANITARY	WATER	STORM
1. Distance from San. M.H. <u>5367</u> toward San. M.H. <u>5239</u> to lot service connection point is:	1.56m	N/A	N/A
1a.Distance from Stm. M.H. 3800 toward Stm. M.H. 3847 to lot service connection point is:	N/A	N/A	10.32m
2. Main Size at connection point is	200mmØ	200mmØ	375mmØ
3. Invert of main at conn. stub point is	640.54m	642.22m	640.76m
4. Invert at service end is	642.42m	642.45m	642.42m
5. Cover at property line in meters	2.21m	2.37m	2.25m
6. Survey Date: JUNE 2015 Book Ref.:1432-03 By:L&M ENGINEERING LTD.			
		<u>I</u>	
SANITARY HISTORY:			
DATE INSTALLED: JUNE 2015			
INSTALLED BY: JOE ROBERTS CONSTRUCTION & CONSULTING SERVICE LTD.			
WATER HISTORY			
WATER HISTORY:			
DATE INSTALLED: JUNE 2015			
INSTALLED BY: JOE ROBERTS CONSTRUCTION & CONSULTING SERVICE LTD.			
STORM HISTORY			
STORM HISTORY:			
DATE INSTALLED: JUNE 2015			
INSTALLED BY: JOE ROBERTS CONSTRUCTION & CONSULTING SERVICE LTD.			