

City of Prince George

HISTORY SHEET

PID: 029-734-886

Scale: 1:500

Legal: LOT 16

D.L.: 1433

PLAN: EPP55599

Address: 2938 ELLINGTON CRT

Sanitary Connection:#	SIZE: 100mmØ	MATERIAL: PVC	INV. 647.15m	CONNECTED
-----------------------	--------------	---------------	--------------	-----------

Water Connection:#	SIZE: 19mmØ	MATERIAL: COPPER	INV. 647.15m	CONNECTED
--------------------	-------------	------------------	--------------	-----------

Storm Connection:#	SIZE: 100mmØ	MATERIAL: PVC	INV. 647.14m	CONNECTED
--------------------	--------------	---------------	--------------	-----------

Cash Receipt No's:	WATER	SANITARY	STORM
--------------------	-------	----------	-------

CURB FROM PROPERTY LINE	5m	PAVEMENT WIDTH	10m
-------------------------	----	----------------	-----

HYDRO	75mm DB2	U/G CONNECTION	✓
-------	----------	----------------	---


TELEPHONE	50mm DB2	U/G CONNECTION	✓
-----------	----------	----------------	---

GAS	42 PROP/P.E.		
-----	--------------	--	--

Information Sheets: REF. DWGS. L&M ENGINEERING LTD. JOB 1432-03

Comments:	CS CURB STOP CO CLEAN OUT	SDW WATER SERVICE SDS STORM SERVICE SDS SANITARY SERVICE	HYDRO SERVICE CABLE SERVICE TELECOMMUNICATIONS	GAS E GAS ELECTRICAL
-----------	------------------------------	--	--	-------------------------------

THE INFORMATION CONTAINED HEREIN IS FOR INTERNAL USE ONLY.
NOT TO BE RELIED UPON UNLESS CONFIRMED BY THE SITE INSPECTION AND/OR INVESTIGATION

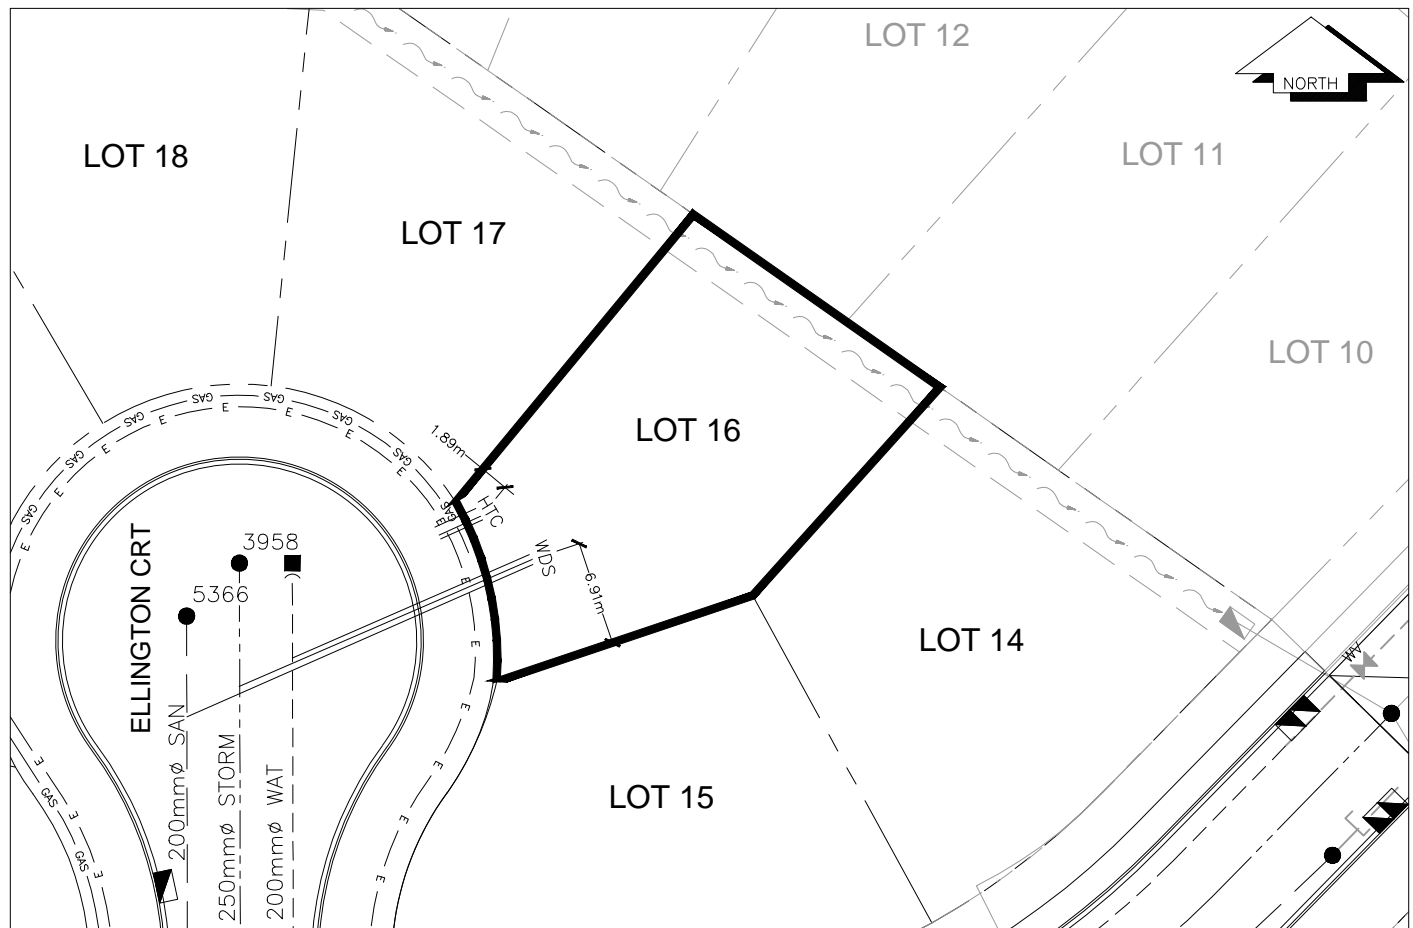

SANITARY, STORM & WATER SERVICE INVERTS	SANITARY	WATER	STORM
1. Distance from San. M.H. <u>5366</u> toward San. M.H. <u>5368</u> to lot service connection point is:	6.56m	N/A	N/A
1a.Distance from Stm. M.H. <u>3958</u> toward Stm. M.H. <u>3847</u> to lot service connection point is:	N/A	N/A	8.20m
2. Main Size at connection point is	200mmØ	200mmØ	250mmØ
3. Invert of main at conn. stub point is	646.59m	646.87m	646.40m
4. Invert at service end is	647.17m	647.22m	647.16m
5. Cover at property line in meters	2.40m	2.48m	2.41m
6. Survey Date:JUNE 2015 Book Ref.:1432-03 By:L&M ENGINEERING LTD.			

SANITARY HISTORY:

DATE INSTALLED: JUNE 2015

INSTALLED BY: JOE ROBERTS CONSTRUCTION & CONSULTING SERVICE LTD.

WATER HISTORY:

DATE INSTALLED: JUNE 2015

INSTALLED BY: JOE ROBERTS CONSTRUCTION & CONSULTING SERVICE LTD.

STORM HISTORY:

DATE INSTALLED: JUNE 2015

INSTALLED BY: JOE ROBERTS CONSTRUCTION & CONSULTING SERVICE LTD.