
## City of Prince George HISTORY SHEET

PID:	029-734-894					Sca	ale: 1:500			
Legal:	LOT 17					D.L	: 1433		PLAN: EPP55599	
Address	: 2944 ELLING	TON CRT								
Sanitary	Connection:#		SIZE:	100mmØ	MATERIAL:	PVC	INV.	647.00m	CONNECTED	
Water C	connection:#		SIZE:	19mmØ	MATERIAL:	COPPER	INV.	646.94m	CONNECTED	
Storm C	connection:#		SIZE	100mmØ	MATERIAL	PVC	INV.	646.99m	CONNECTED	
Cash Receipt No's:			WATER		SANITARY		STORM			
CURB FROM PROPER		RTY LINE 5m						PAVEMEN	Г WIDTH 10m	
HYDRO		75mm DB2				U/G CONNECT	ION	<u> </u>		
TELEPH	HONE	50mm DB2				U/G CONNECT	CONNECTION			
GAS		42 PROP/P.E.								
Informat	ormation Sheets: REF. DWGS. L&M ENGINEERING LTD. JOB 1432-03									
Comme	nts:							— GAS — GAS ONS — E — ELECTRICAL		

## THE INFORMATION CONTAINED HEREIN IS FOR INTERNAL USE ONLY. NOT TO BE RELIED UPON UNLESS CONFIRMED BY THE SITE INSPECTION AND/OR INVESTIGATION

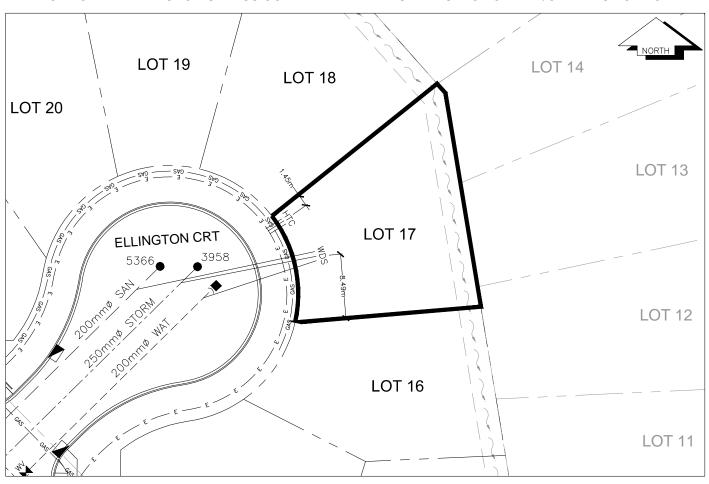

SANITARY, STORM & WATER SERVICE INVERTS	SANITARY	WATER	STORM
1. Distance from San. M.H. <u>5366</u> toward San. M.H. <u>5368</u> to lot service connection point is:	4.25m	N/A	N/A
1a.Distance from Stm. M.H. 3958 toward Stm. M.H. 3847 to lot service connection point is:	N/A	N/A	3.00m
2. Main Size at connection point is	200mmØ	200mmØ	250mmØ
3. Invert of main at conn. stub point is	646.62m	646.59m	646.53m
4. Invert at service end is	647.08m	647.05m	647.07m
5. Cover at property line in meters	2.67m	2.80m	2.67m
6. Survey Date: JUNE 2015 Book Ref.:1432-03 By:L&M ENGINEERING LTD.			
			1
SANITARY HISTORY:			
DATE INSTALLED: JUNE 2015			
INSTALLED BY: JOE ROBERTS CONSTRUCTION & CONSULTING SERVICE LTD.			
INSTALLED BT. 30E ROBERTS CONSTRUCTION & CONSOLTING SERVICE ETD.			
WATER HISTORY:			
DATE INSTALLED: JUNE 2015			
INSTALLED BY: JOE ROBERTS CONSTRUCTION & CONSULTING SERVICE LTD.			
STORM HISTORY:			
DATE INSTALLED: JUNE 2015			
INSTALLED BY: JOE ROBERTS CONSTRUCTION & CONSULTING SERVICE LTD.			