
City of Prince George HISTORY SHEET

PID:	029-734-924					Sca	ale: 1:500			
Legal:	LOT 20					D.L	.: 1433		PLAN: EF	P55599
Address	: 2966 ELLINGT	ON CRT								
Sanitary	Connection:#		SIZE:	100mmØ	MATERIAL:	PVC	INV.	647.03m	CONNECT	ED
Water C	Connection:#		SIZE:	19mmØ	MATERIAL:	COPPER	INV.	647.04m	CONNECT	ED
Storm C	connection:#		SIZE	100mmØ	MATERIAL	PVC	INV.	647.02m	CONNECT	ED
Cash Re	eceipt No's:			WATER		SANITARY			STORM	
CURB FROM PROPER		RTY LINE 5m						PAVEMEN	Г WIDTH 10)m
HYDRO		75mm DB2				U/G CONNECT	ION			
TELEPH	HONE	50mm DB2				U/G CONNECT	ION			
GAS	42 PROP/P.E.									
Informat	formation Sheets: REF. DWGS. L&M ENGINEERING LTD. JOB 1432-03									
Comme	nts:	CS CURB STOP WATER SERVICE THYDRO SERVICE GAS CO CLEAN OUT SANITARY SERVICE TELECOMMUNICASTIONS E ELECT						GAS ELECTRICAL		

THE INFORMATION CONTAINED HEREIN IS FOR INTERNAL USE ONLY. NOT TO BE RELIED UPON UNLESS CONFIRMED BY THE SITE INSPECTION AND/OR INVESTIGATION

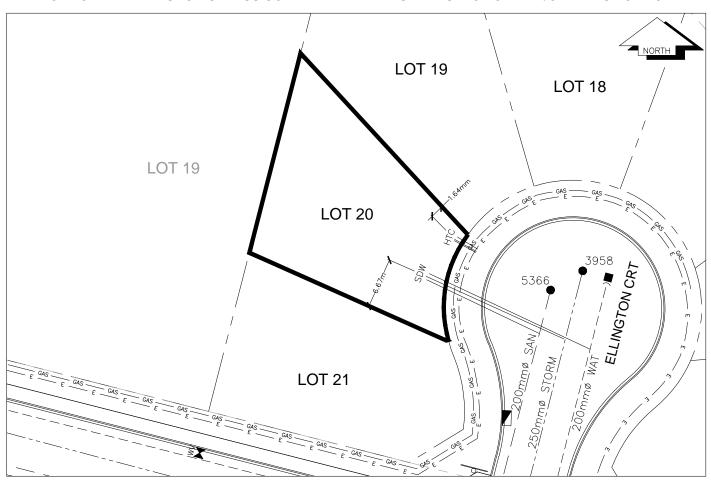

SANITARY, STORM & WATER SERVICE INVERTS	SANITARY	WATER	STORM	
1. Distance from San. M.H. <u>5366</u> toward San. M.H. <u>5368</u> to lot service connection point is:	6.09m	N/A	N/A	
1a.Distance from Stm. M.H. 3958 toward Stm. M.H. 3847 to lot service connection point is:	N/A	N/A	9.62m	
2. Main Size at connection point is	200mmØ	200mmØ	250mmØ	
3. Invert of main at conn. stub point is	646.56m	646.55m	646.37m	
4. Invert at service end is	647.07m	647.09m	647.08m	
5. Cover at property line in meters	2.56m	2.63m	2.56m	
6. Survey Date: JUNE 2015 Book Ref.:1432-03 By:L&M ENGINEERING LTD.				
SANITARY HISTORY:				
DATE INSTALLED: JUNE 2015				
INSTALLED BY: JOE ROBERTS CONSTRUCTION & CONSULTING SERVICE LTD.			-	
			-	
			-	
WATER HISTORY:				
DATE INSTALLED: JUNE 2015				
INSTALLED BY: JOE ROBERTS CONSTRUCTION & CONSULTING SERVICE LTD.				
STORM HISTORY:				
DATE INSTALLED: JUNE 2015				
INSTALLED BY: JOE ROBERTS CONSTRUCTION & CONSULTING SERVICE LTD.				