



City of Prince George History Sheet

| | |
|--------|-----------|
| PID: | 029750890 |
| SD/MU: | |
| WO: | |

Civic Address: 3090 Spruce St

Legal Description: Lot: 1 District Lot: 913 Plan: EPP50874


| Service Type | Diameter (mm) | Material | Invert Elev at main (m) | Invert Elev at property line (m) | Invert Elev at service end (m) | Distance into property (m) | Installation Date |
|--------------|---------------|----------|-------------------------|----------------------------------|--------------------------------|----------------------------|-------------------|
| Sanitary | 100mm | PVC | - | - | - | - | January 1969 |
| Water | 20mm | Copper | - | - | - | - | |
| Storm | N/A | N/A | - | - | - | - | |

| Service Connection Location | | | | | Sanitary (m) | Storm (m) |
|---------------------------------|------|-------------------------|------|--|--------------|-----------|
| Distance from downstream San MH | 4938 | towards upstream San MH | 1804 | | - | |
| Distance from downstream Stm MH | 3459 | towards upstream Stm MH | 802 | | | |

| Power | Size | Communications | Size | Cable | Size | Gas | Size |
|------------------|------|------------------|------|------------------|------|----------|------|
| BC Hydro | - | Telus | - | Shaw | - | FortisBC | - |
| Overhead Service | | Overhead Service | | Overhead Service | | | |

| | | |
|---------------|--------------|---|
| Installed by: | Survey Date: | - |
| Comments: | | |
| | | |
| | | |

NOT TO SCALE The information contained herein is for internal use only.
Not to be relied on unless confirmed by site inspection and/or investigation.

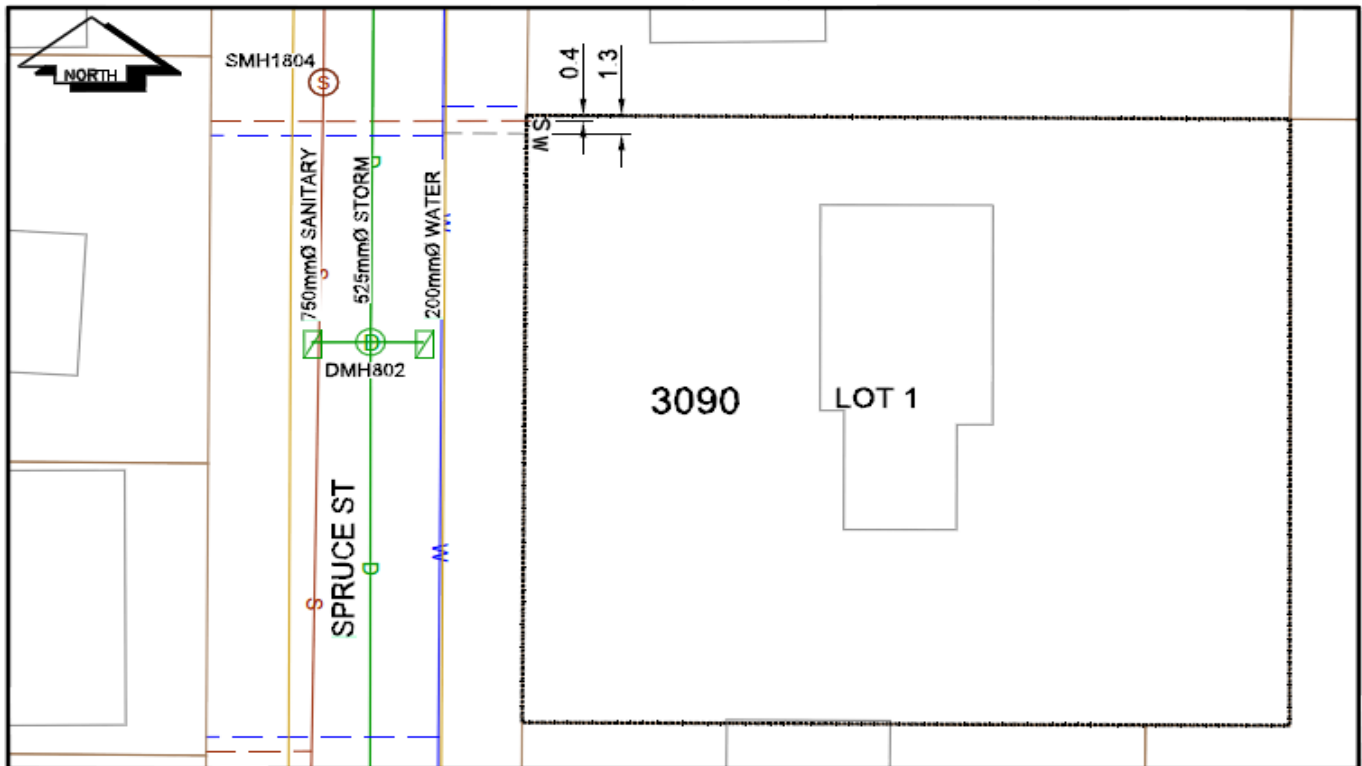

| | | | | | | | |
|----|-----------|-----|---|------------------|-----|---|---------------|
| CS | CURB STOP | --- | W | WATER SERVICE | --- | D | STORM SERVICE |
| CO | CLEAN OUT | --- | S | SANITARY SERVICE | --- | G | GAS |

NOT TO SCALE