



City of Prince George History Sheet

PID:	0297509
MU:	100918
WO:	44341

Civic Address: 3089 Clapperton St

Legal Description: Lot: 2 District Lot: 913 Plan: EPP50874


Service Type	Diameter (mm)	Material	Invert Elev at main (m)	Invert Elev at property line (m)	Invert Elev at service end (m)	Distance into property (m)	Installation Date
Sanitary	100mm	PVC	-	-	-	-	June 1988
Water	100mm	PVC	-	-	-	-	December 2008
Storm	100mm	PVC	-	-	-	-	June 1988

Service Connection Location					Sanitary (m)	Storm (m)
Distance from downstream San MH	1813	towards upstream San MH	1812		52.65	
Distance from downstream Stm MH	799	towards upstream Stm MH	800			78.91

Power	Size	Communications	Size	Cable	Size	Gas	Size
BC Hydro	-	Telus	-	Shaw	-	FortisBC	-
Overhead Service		Overhead Service		Overhead Service			

Installed by:	City of Prince George forces	Survey Date:	-
Comments:	Existing 20mm water service was disconnected at main and abandoned		

NOT TO SCALE The information contained herein is for internal use only.
Not to be relied on unless confirmed by site inspection and/or investigation.

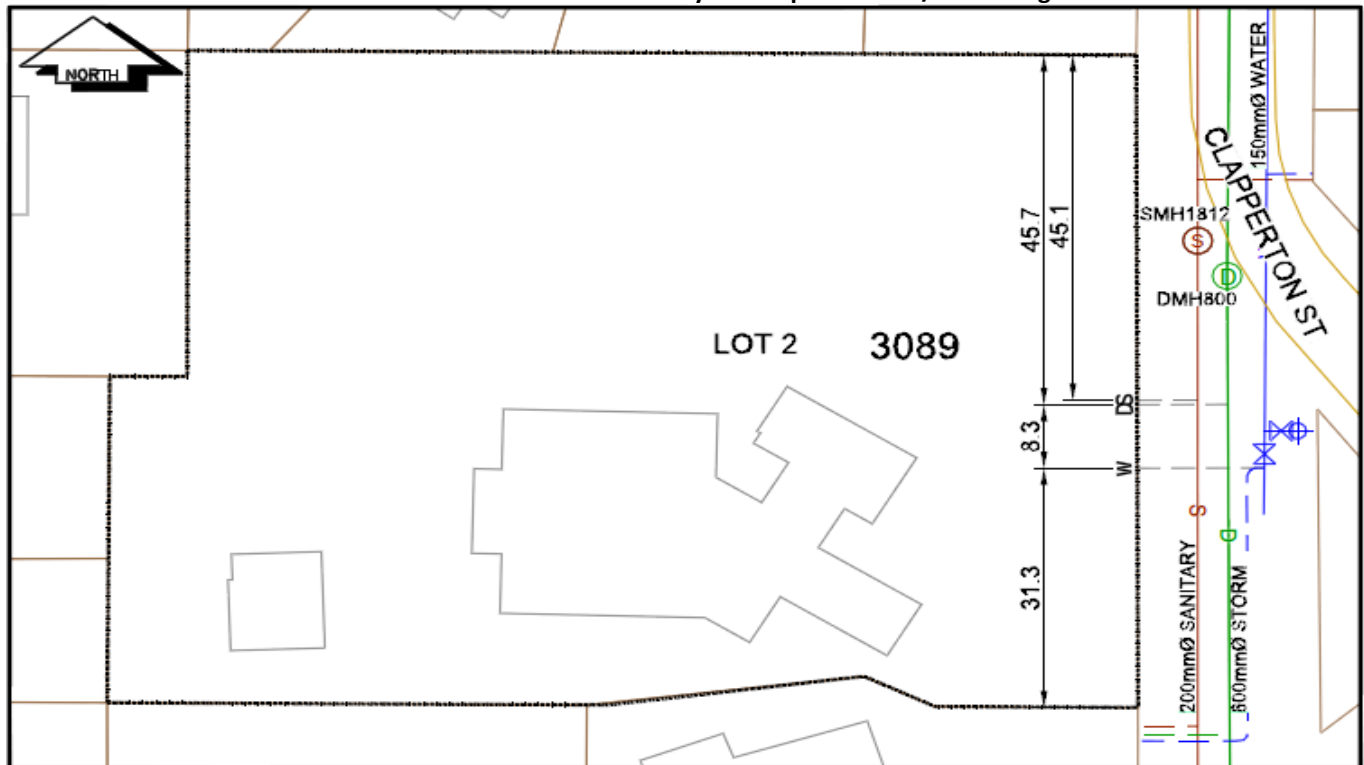

LEGEND:	CURB STOP	WATER SERVICE	STORM SERVICE
	CLEAN OUT	SANITARY SERVICE	GAS

NOT TO SCALE