



City of Prince George History Sheet

PID:	029767857
SD:	100455
WO:	

Civic Address: 2999 Charella Dr

Legal Description: Lot: A District Lot: 9261 Plan: EPP42878


Service Type	Diameter (mm)	Material	Invert Elev at main (m)	Invert Elev at property line (m)	Invert Depth at service end (m)	Distance into property (m)	Installation Date
Sanitary	100mm	Unknown	-	-	2.40	-	June 1981
Water	20mm	Copper	-	-	-	-	June 1981
Storm	100mm	Unknown	-	-	2.40	-	June 1981

Service Connection Location					Sanitary (m)	Storm (m)
Distance from downstream San MH	3563	towards upstream San MH	3564		68.70	
Distance from downstream Stm MH	1806	towards upstream Stm MH	1804			79.20

Power	Size	Communications	Size	Cable	Size	Gas	Size
BC Hydro	-	Telus	-	Shaw	-	FortisBC	-
Overhead Service		Overhead Service		Overhead Service			

Installed by:	Survey Date:	-
Comments:		

NOT TO SCALE The information contained herein is for internal use only.
Not to be relied on unless confirmed by site inspection and/or investigation.

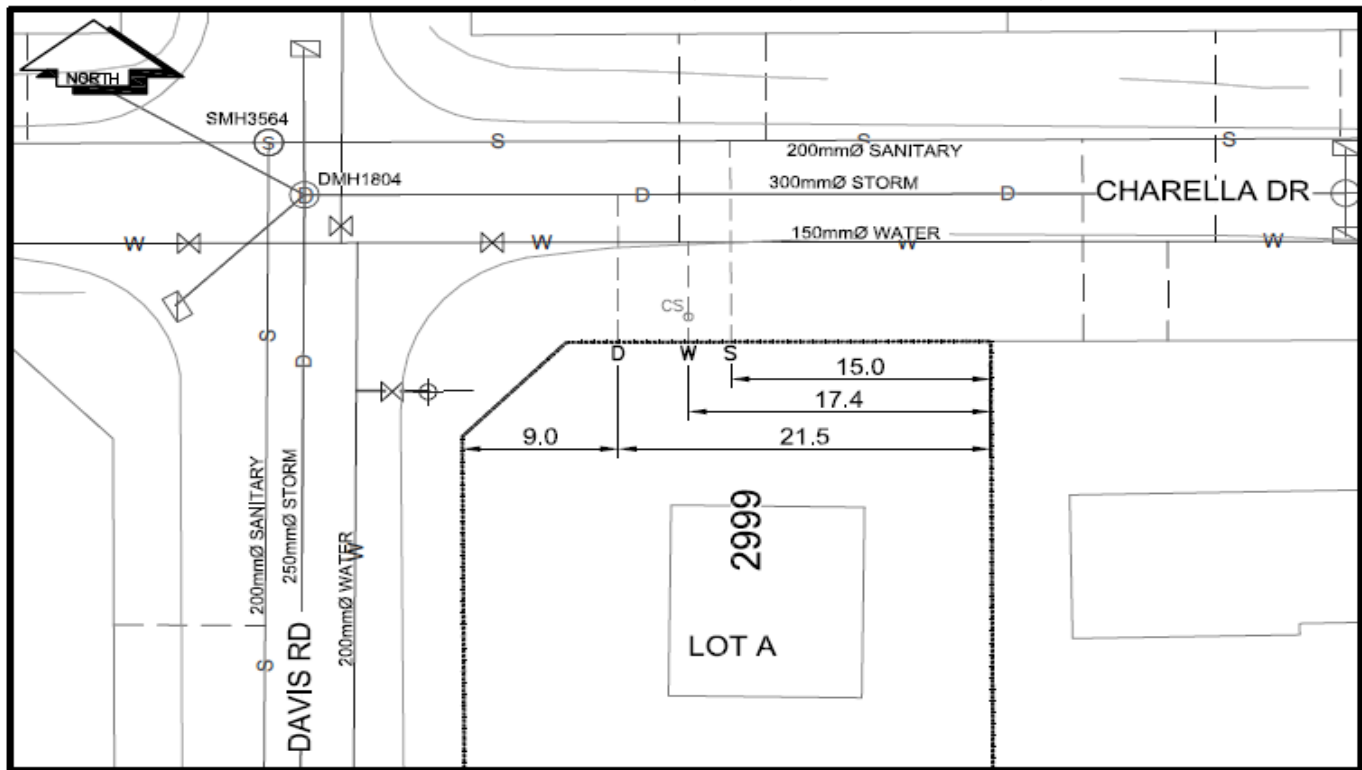

LEGEND:	CS CURB STOP	--- W WATER SERVICE	--- D STORM SERVICE
	CO CLEAN OUT	--- S SANITARY SERVICE	--- G GAS

NOT TO SCALE