



City of Prince George History Sheet

PID:	029767865
MU:	101494
WO:	78930/ 78931
	78929

Civic Address: 4056 Davis Rd

Legal Description: Lot: B District Lot: 9261 Plan: EPP42878


Service Type	Diameter (mm)	Material	Invert Elev at main (m)	Invert Elev at property line (m)	Invert Elev at service end (m)	Distance into property (m)	Installation Date
Sanitary	100mm	PVC	-	-	-	-	July 2014
Water	20mm	Copper	-	-	-	-	July 2014
Storm	100mm	PVC	-	-	-	-	July 2014

Service Connection Location				Sanitary (m)	Storm (m)
Distance from downstream San MH	3504	towards upstream San MH	3610	68.57	
Distance from downstream Stm MH	1804	towards upstream Stm MH	1807		65.21

Power	Size	Communications	Size	Cable	Size	Gas	Size
BC Hydro	-	Telus	-	Shaw	-	FortisBC	-
Overhead Service		Overhead Service		Overhead Service			

Installed by:	City of Prince George forces	Survey Date:	-
Comments:			

NOT TO SCALE The information contained herein is for internal use only.
Not to be relied on unless confirmed by site inspection and/or investigation.

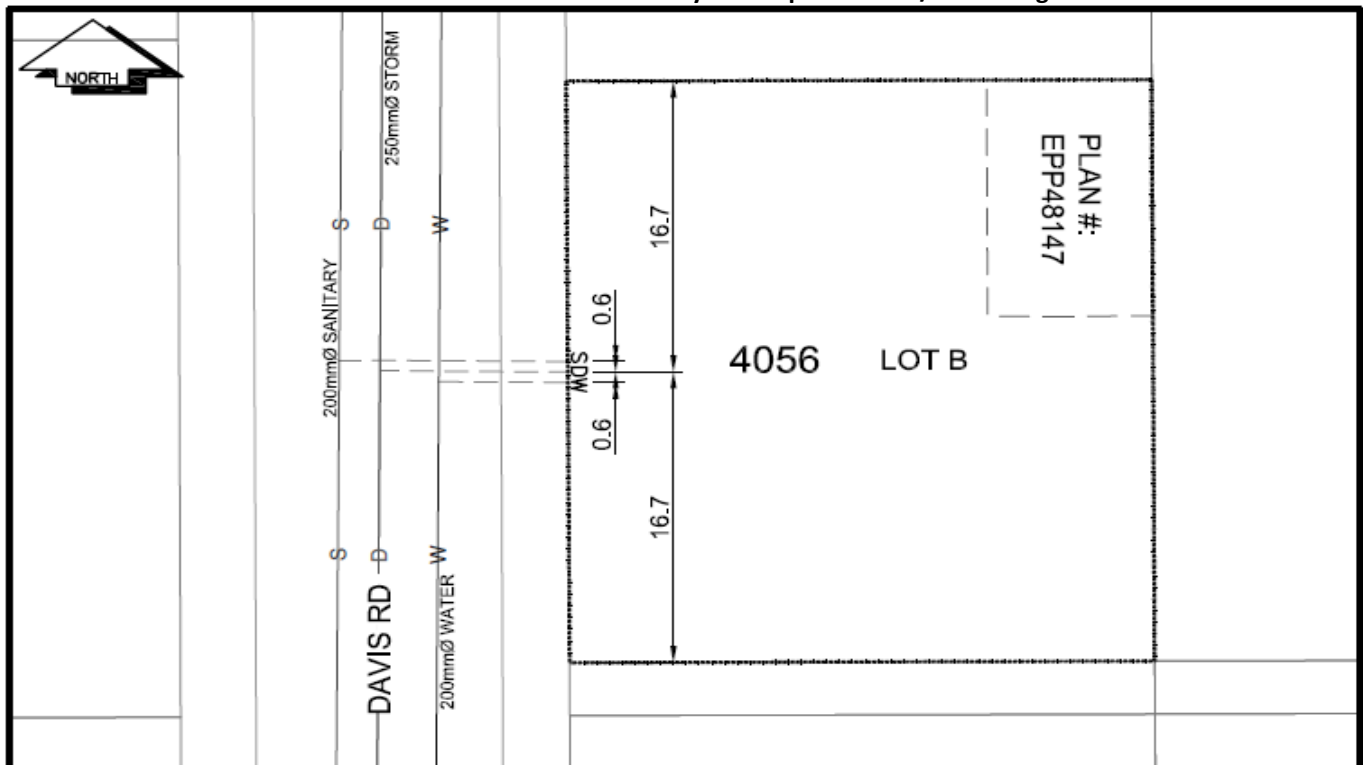

LEGEND:	CS CURB STOP	--- W WATER SERVICE	--- S SANITARY SERVICE	--- G GAS
	CO CLEAN OUT			

NOT TO SCALE