



City of Prince George History Sheet

PID:	029787416
MU:	102077
WO:	97564/97561

Civic Address: 506 Gillett St

Legal Description: Lot: A District Lot: 937 Plan: EPP58903


Service Type	Diameter (mm)	Material	Invert Elev at main (m)	Invert Elev at property line (m)	Invert Elev at service end (m)	Distance into property (m)	Installation Date
Sanitary	150mm	PVC	-	-	-	-	October 2018
Water	100mm	PVC	-	-	-	-	October 2018
Storm	250mm	PVC	593.48	-	-	-	October 2018

Service Connection Location	Sanitary (m)	Storm (m)
150mm Sanitary service connected to NEW San MH	-	
250mm Storm service connected to NEW Stm MH		

Power	Size	Communications	Size	Cable	Size	Gas	Size
BC Hydro	-	Telus	-	Shaw	-	FortisBC	-
Underground Service		Underground Service		Underground Service			

Installed by:	City of Prince George forces	Survey Date:	-
Comments:			

NOT TO SCALE The information contained herein is for internal use only.
Not to be relied on unless confirmed by site inspection and/or investigation.

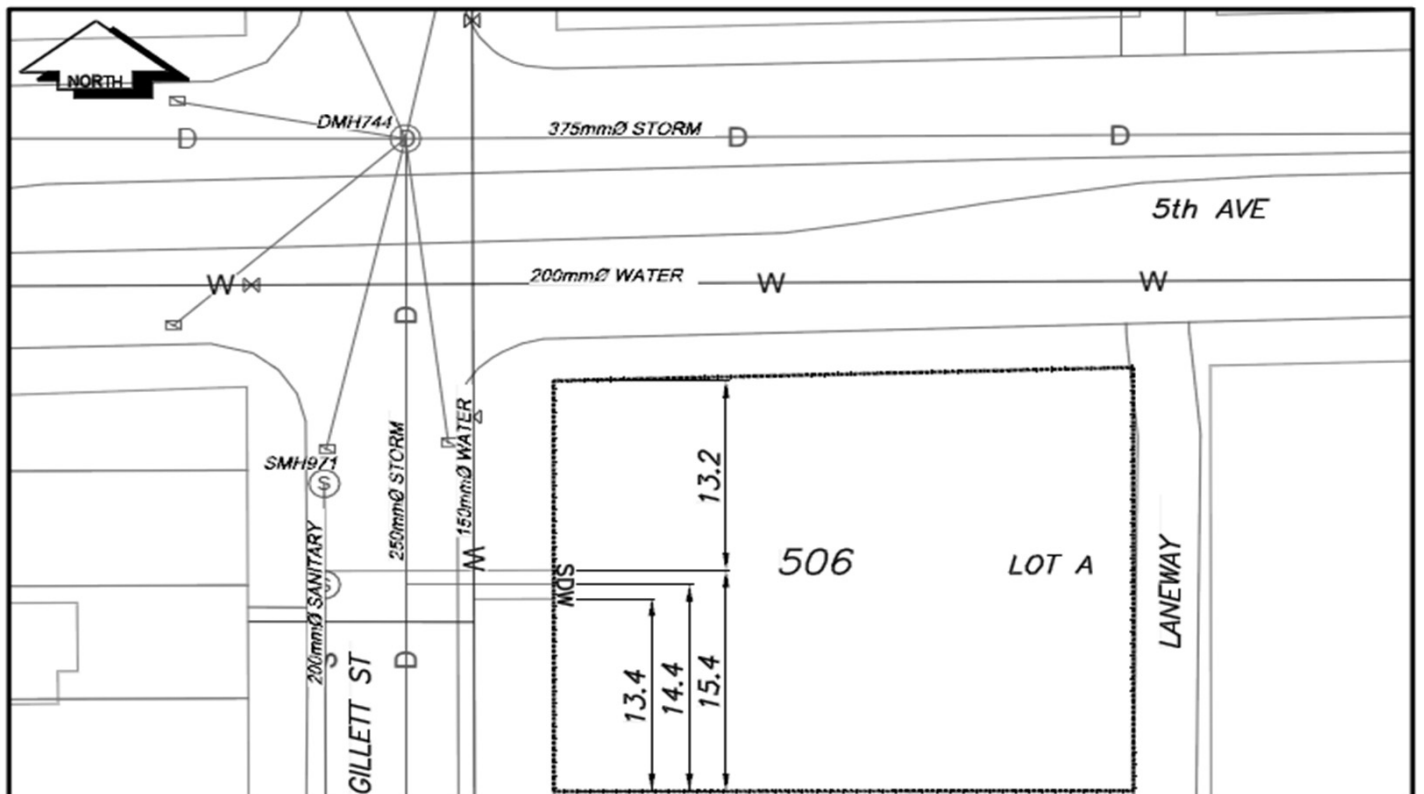

CS ^o CURB STOP	— W — WATER SERVICE	— D — STORM SERVICE
CO ^o CLEAN OUT	- - - S - SANITARY SERVICE	— G — GAS
⊗ WATER VALVE	⊗ FIRE HYDRANT	- - - - ENCUMBRANCE

NOT TO SCALE