



# City of Prince George History Sheet

PID:	029826748
MU:	101806
WO:	89735/89736

Civic Address: 966 Central St East

Legal Description: Lot: PCL C Block: 51 (CA5165695) District Lot: 936 Plan: 696


Service Type	Diameter (mm)	Material	Invert Elev at main (m)	Invert Elev at property line (m)	Invert Elev at service end (m)	Distance into property (m)	Installation Date
Sanitary	100mm	PVC	597.77	598.24	598.27	0.71	September 2016
Water	40mm	Copper	597.90	598.09	598.01	2.27	September 2016
Storm	N/A	N/A	-	-	-	-	

Service Connection Location				Sanitary (m)	Storm (m)
Distance from downstream San MH	1957	towards upstream San MH	2749	69.38	
Distance from downstream Stm MH	-	towards upstream Stm MH	-		

Power	Size	Communications	Size	Cable	Size	Gas	Size
BC Hydro	-	Telus	-	Shaw	-	FortisBC	-
Overhead Service		Overhead Service		Overhead Service			

Installed by:	City of Prince George forces	Survey Date:	-
Comments:	Sanitary abandoned and water disconnected September 26, 2016.		

**NOT TO SCALE** The information contained herein is for internal use only.  
Not to be relied on unless confirmed by site inspection and/or investigation.

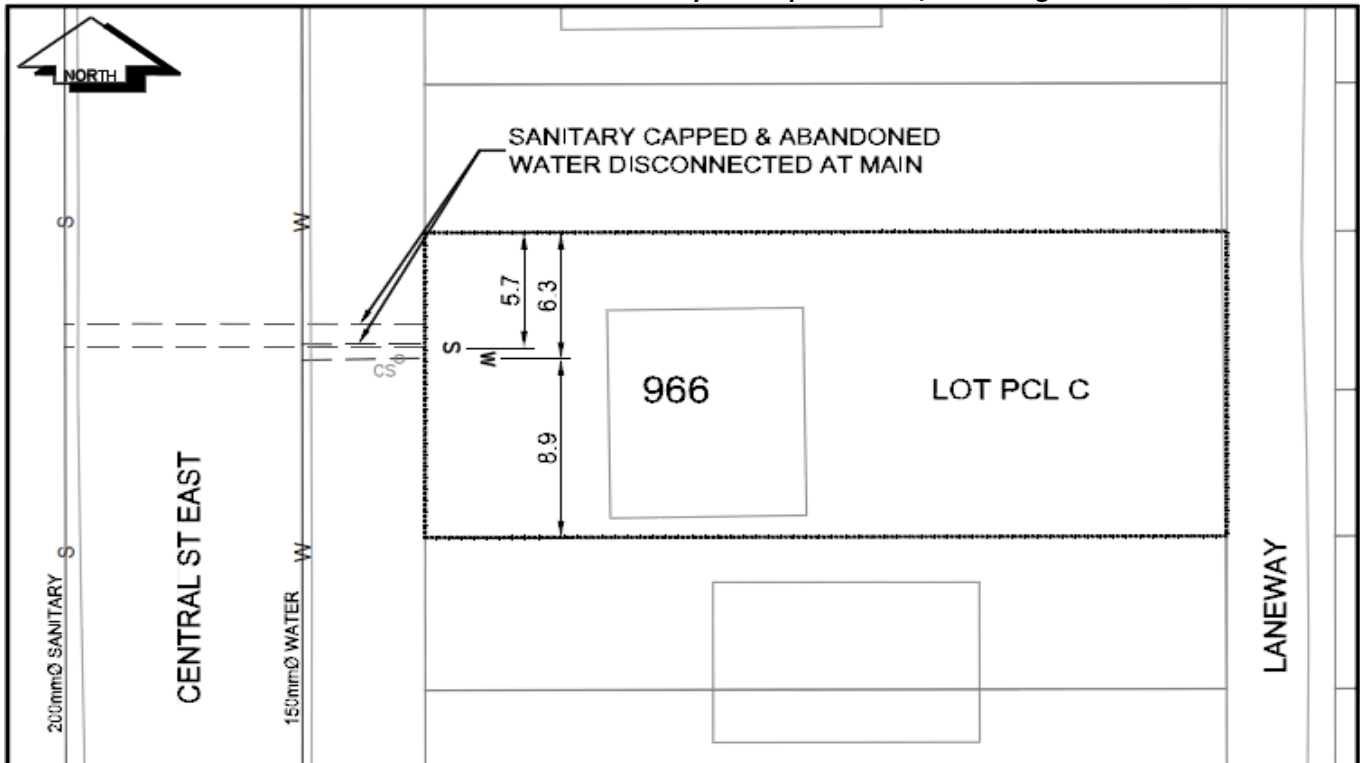

CS	CURB STOP	---	W	WATER SERVICE	---	⊕	STORM SERVICE
CO	CLEAN OUT	---	S	SANITARY SERVICE	---	G	GAS
⊗	WATER VALVE	---	⊕	FIRE HYDRANT	---	---	ENCUMBRANCE

**NOT TO SCALE**