

City of Prince George

HISTORY SHEET

PID: 029-840-601

Scale: 1:1500

Legal: LOT 2

D.L.: 748

PLAN: EPP46674

Address: 7150 BOUNDARY CRT

Sanitary Connection:#	SIZE: 150mmØ	MATERIAL: PVC	INV. AT R 668.51m	CONNECTED
-----------------------	--------------	---------------	-------------------	-----------

Water Connection:#	SIZE: 150mmØ	MATERIAL: PVC	INV. AT R 667.17m	CONNECTED
--------------------	--------------	---------------	-------------------	-----------

Storm Connection:#	SIZE: 250mmØ	MATERIAL: PVC	INV. AT R 667.53m	CONNECTED
--------------------	--------------	---------------	-------------------	-----------

Cash Receipt No's:	WATER	SANITARY	STORM
--------------------	-------	----------	-------

CURB FROM PROPERTY LINE	6m	PAVEMENT WIDTH	13m
-------------------------	----	----------------	-----

HYDRO	75mm DB2	U/G CONNECTION	✓
-------	----------	----------------	---


TELEPHONE	100mm DB2	U/G CONNECTION	✓
-----------	-----------	----------------	---

GAS	42 PROP/P.E.		
-----	--------------	--	--

Information Sheets: REF. DWGS. L&M ENGINEERING LTD. JOB. 1282-11 DWGS.

Comments:	CS CURB STOP CO CLEAN OUT	WATER SERVICE STORM SERVICE SANITARY SERVICE	HYDRO SERVICE CABLE SERVICE TELECOMMUNICATIONS	GAS ELECTRICAL
-----------	------------------------------	--	--	-------------------

THE INFORMATION CONTAINED HEREIN IS FOR INTERNAL USE ONLY.
NOT TO BE RELIED UPON UNLESS CONFIRMED BY THE SITE INSPECTION AND/OR INVESTIGATION

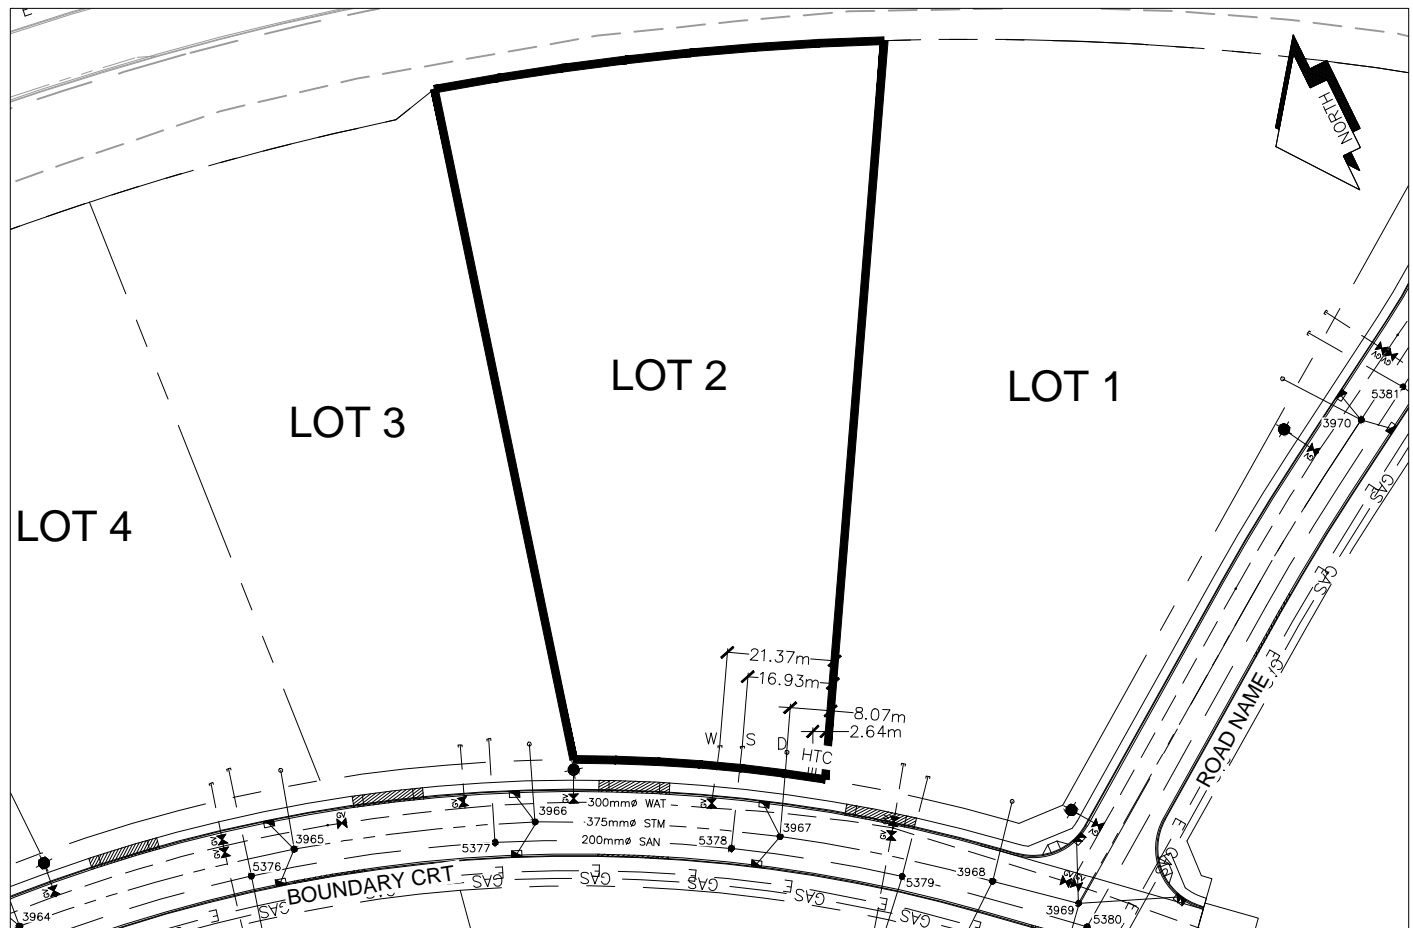

SANITARY, STORM & WATER SERVICE INVERTS	SANITARY	WATER	STORM
1. Lot service installed directly into San. M.H. <u>5378</u>	N/A	N/A	N/A
1. Lot service installed directly into Stm. M.H. <u>3967</u>	N/A	N/A	N/A
2. Main Size at connection point is	MH	300mmØ	MH
3. Invert of service at main conn. stub point is	668.38m	667.27m	667.57m
4. Invert at service end is	668.55m	667.20m	667.41m
5. Cover at property line in meters	1.79m	3.15m	2.63m
6. Survey Date:AUG 2014 Book Ref.:1282-11 By:L&M ENGINEERING LTD			

SANITARY HISTORY:

DATE INSTALLED: AUG 2014

INSTALLED BY: BOUNDARY ROAD BUILDERS LTD

WATER HISTORY:

DATE INSTALLED: AUG 2014

INSTALLED BY: BOUNDARY ROAD BUILDERS LTD

STORM HISTORY:

DATE INSTALLED: AUG 2014

INSTALLED BY: BOUNDARY ROAD BUILDERS LTD