
City of Prince George HISTORY SHEET

PID:	029-840-643					Sca	le: 1:1500			
Legal:	LOT 6					D.L	.: 748		PLAN:	EPP46674
Address	: 6920 BOUNE	DARY CRT								
Sanitary	Connection:#		SIZE:	150mmØ	MATERIAL:	PVC	INV. AT PL	669.53m	CONNE	CTED
Water C	onnection:#		SIZE:	150mmØ	MATERIAL:	PVC	INV. AT PL	668.11m	CONNE	CTED
Storm C	onnection:#		SIZE	250mmØ	MATERIAL	PVC	INV. AT PL	668.85m	CONNE	CTED
Cash Receipt No's:		WATER		SANITARY	ARY ST		FORM			
CURB F	ROM PROPER	TY LINE	6m				P.	AVEMENT V	/IDTH	13m
HYDRO		75mm DB2				U/G CONNECT	ION ~	/		
TELEPH	HONE	100mm DB	2			U/G CONNECT	ION ~	/		
GAS	S 42 PROP/P.E.									
Informat	ion Sheets:	F	REF. DWGS	L&M ENGINEE	ERING LTD. JOB					
Comme	nts:	CS CI	JRB STOP LEAN OUT		WATER SERVIC STORM SERVIC SANITARY SERV	E E /ICE	_ HYDRO SER CABLE SER TELECOMM	RVICE VICE UNICASTION	GAS	GAS ELECTRICAL

THE INFORMATION CONTAINED HEREIN IS FOR INTERNAL USE ONLY. NOT TO BE RELIED UPON UNLESS CONFIRMED BY THE SITE INSPECTION AND/OR INVESTIGATION

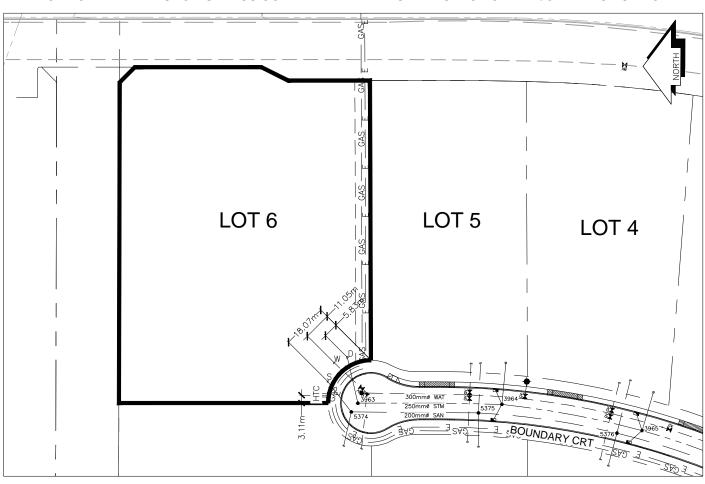

SANITARY, STORM & WATER SERVICE INVERTS	SANITARY	WATER	STORM
Lot service installed directly into San. M.H. <u>5374</u>	N/A	N/A	N/A
Lot service installed directly into Stm. M.H. <u>3963</u>	N/A	N/A	N/A
2. Main Size at connection point is	MH	300mmØ	MH
3. Invert of service at main conn. stub point is	669.31m	668.02m	668.68m
4. Invert at service end is	669.57m	668.14m	668.89m
5. Cover at property line in meters	1.93m	3.31m	2.45m
6. Survey Date: AUG 2014 Book Ref.:1282-11 By:L&M ENGINEERING LTD			
			1
SANITARY HISTORY:			
DATE INSTALLED: AUG 2014			
INSTALLED BY: BOUNDARY ROAD BUILDERS LTD			
THO THE ELEB BY BOOK BY THO TO BE BUILDE IN C. I.B.			
WATER HISTORY:			
DATE INSTALLED: AUG 2014			
INSTALLED BY: BOUNDARY ROAD BUILDERS LTD			
OTODAL HOTODY			
STORM HISTORY:			
DATE INSTALLED: AUG 2014			
INSTALLED BY: BOUNDARY ROAD BUILDERS LTD			